


**CERTIFIED RECORD OF LAND CORNER MONUMENTATION**

**HISTORY OF ORIGINAL CORNER ESTABLISHED:**

Original corner set by Rufus Moore, under GLO contract No. 451, dated June 12, 1882. Surveyor General Record States: Set a post 4 ft. long, 4 ins. square, 24 ins. in the ground for cor. to secs. 17, 18, 19 and 20, 50 ft. above Indian trail, from which:  
A fir, 10 ins. in dia. bears N30°E, 30 lks. dist. marked T2S R35E S17 BT.  
A fir, 6 ins. in dia. bears N38°W, 12 lks. dist., marked T2S R35E S18 BT.  
A fir 10 ins. in dia. bears S47°W, 36 lks. dist. marked T2S R35E S19 BT.  
A fir 8 ins. in dia. bears S35°E, 6 lks. dist. marked T2S R35E S20 BT.

**T 2 S R 35 E N-05**

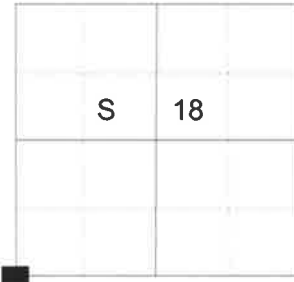

Corner recovered and replaced by L.E. Wilkes under GLO special instructions dated February 20, 1917, included under Group No. 29. Field Notes state:  
The cor. of secs. 17, 18, 19 and 20, which is an old post, 4 ins. sq., firmly set, marked and witnessed as described by the surveyor general, except that all bearing trees are now dead. I perpetuate this cor., as follows: at the exact cor. point.  
Set a volcanic stone, 20x16x6 ins., 15 ins. in the ground, for cor. of secs. 17, 18, 19 and 20, marked with 3 notches on S. and 5 notches on E. edge, from which:  
A tamarack, 20 ins. diam., bears N.45°45'E., 97 lks. dist., marked T2S R35E S17 BT.  
A balsam, 7 ins. diam., bears S.67°E., 54 lks. dist., marked T2S R35E S20 BT.  
A balsam, 7 ins. diam., bears S.12°W., 62 lks. dist., marked T2S R35E S19 BT.  
A pine, 30 ins. diam., bears N.47°30'W., 28 lks. dist., marked T2S R35E S18 BT.

In 1968, Ralph Thompson recovers and replaced the volcanic stone. Umatilla County Monumentation records state:  
Found Original stone, 20x16x6, 15 ins. in the ground, marked with 3 notches on S. and 5 notches on E. edge.  
At the exact corner, I set a 1x36 inch galvanized pipe with a 2 1/2" brass cap securely fastened to the top. I buried the original stone alongside of the pipe and raised a mound of earth and stones around it. from which bears the new bearing trees.  
A fir 8 ins. in diam N.20°28'E. 31.10 ft. mkd. T2S R35E S17 CSBT  
A white fir 15 ins. diam. S25°34'E 37.75 ft. dist. mkd T2S R35E S20 CSBT  
A W. fir 6 ins. diam. S.62°43'W. 29.10 ft. dist. mkd. T2S R35E S19 CSBT  
A W. fir 5 ins. diam. N.73°W. 51.60 ft. dist. mkd. T2S R35E S18 CSBT

**DESCRIPTION OF CORNER EVIDENCE FOUND:**

Found 2 1/2" brass cap marked as shown below, flush with the ground in a collar of stone, from which:  
A 13" fir stump bears North 20° East, a distance of 31.1 ft. scribe marks visible.  
A 20" fir stump bears South 26° East, a distance of 37.75 feet scribe marks visible.  
A 9" fir stump bears South 62° West, a distance of 29.1 feet, with dead and downed log alongside with scribe marks visible.

**DESCRIPTION OF MONUMENT AND ACCESSORIES I ESTABLISHED**

**TO PERPETUATE THE ORIGINAL LOCATION OF THIS CORNER:**

From the brass cap monument,


**NEW BEARING TREES:**

An 8" Western Larch bears North 48° East, a distance of 26.45 feet, marked T2S R35E S17 BT.  
A 10" Western Larch bears South 36° East, a distance of 70.55 feet, marked T2S R35E S20 BT.  
An 8" Douglas Fir bears South 4° West, a distance of 21.35 feet, marked T2S R35E S19 BT.  
A 7" Ponderosa Pine bears North 84° West, a distance of 34.30 feet, marked T2S R35E S18 BT.

I hereby certify that the corner was perpetuated October 27, 2017.  
Witness: Kyle Tucker



Renewal Date: June 30, 2019

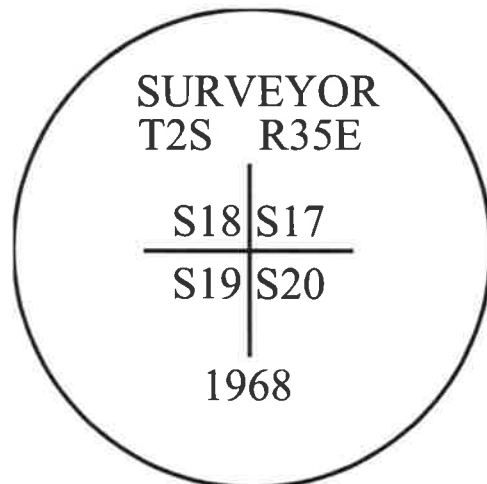

I used a steel tape and magnetic compass in the establishment of the bearing trees. Magnetic declination used was 13° East. Bearing is to a brass washer marked OPLS 83571 in the lower blaze of the tree. Distance is to a spike set in the root crown of the side of the tree.