

N-5


CERTIFIED RECORD OF LAND CORNER MONUMENTATION

Restoration of the SW Cor. of Sec. 17, T. 2 S. R. 35 E. W. M.

History of original corner establishment: Retracement survey Oct., 1917

Volcanic stone, 20x15x6 ins., 15 ins. in the ground for cor. of secs. 17, 18, 19 and 20, marked with 3 notches on S. and 5 notches on E. edge; from which

- A tamarack, 20 ins. diam., bears N. 45° 45' E. 97 lks. dist., marked T 2 S R 35 E S 17 B T.
- A balsam, 7 ins. diam., bears S. 67° E., 54 lks. dist., mkd T 2 S R 35 E S 20 B T.
- A balsam, 7 ins. diam., bears S. 12° W., 62 lks. dist., marked T 2 S R 35 E S 19 B T.
- A pine, 30 ins. diam., bears N. 47° 30' W., 28 lks. dist., marked T 2 S R 35 E S 18 B T.

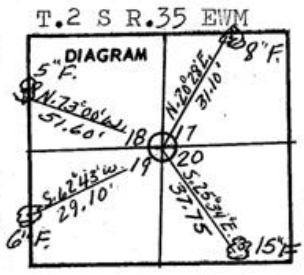

Description of corner evidence found:

Found- Original stone, 20x15x6 ins. 15 ins. in the ground, marked with 3 notches on S. and 5 notches on E. edge; Stone was checked and found to be undisturbed by measuring from the remaining bearing trees, which are,

- A tam snag 20 ins. diam. bears N. 45° 45' E. 97 lks. scribing visible in old blaze
- A balsam snag 9 ins. diam. bears S. 12° W. 62 lks scribing visible in old blaze.
- A pine stump 30" diam. bears N. 47° 30' W. 28 lks dist. scribing visible in old blaze

Description of monument and accessories established to perpetuate the

original location of this corner Cor to 17, 18, 19 & 20, T. 2 S. R. 35 E. W. M. Restored 10-25-68

At the exact corner I set a 1x36 inch galvanized pipe with a 2 1/2 inch brass cap securely fastened to the top marked

UMATILLA COUNTY
 SURVEYOR
 T. 2 S. R. 35 E.
 S. 18 | S. 17
 S. 19 | S. 20
 1968
 ORLS 506

I buried the original stone alongside of the pipe and raised a mound of earth and stones around it. from which bear the new bearing trees.

- A. fir 8 ins. in diam N. 20° 28' E. 31.10 ft. mkd. T 2 S R 35 E S 17 CSBT
- A white fir 15 ins. diam. S. 25° 34' E. 37.75 ft. dist. mkd. T 2 S R 35 E S 20 CSBT
- A W. fir 6 ins. diam. S. 62° 43' W. 29.10 ft. dist. mkd. T 2 S R 35 E S 19 CSBT
- A W. fir 5 ins. diam. N. 73° 04' W. 51.60 ft. dist. mkd. T 2 S R 35 E S 18 CSBT

All angular and linear measurements were taken to the center of the bearing trees with steel tape and Wild T-2 theodolite.

Office of The County Surveyor..... County of..... Umatilla
 State of... Oregon....., I hereby certify that the within instrument was filed in this office
 for record on the 11 day of Nov....., 1968, at..... o'clock..... m., (signed)
Ralph P. Thompson by.....
 (COUNTY OFFICIAL) (DEPUTY)

REGISTERED
 OREGON
 LAND SURVEYOR

Ralph P. Thompson

MAY 13, 1960
 RALPH P. THOMPSON
 506

N-5

Q-886