

USDA-FOREST SERVICE


Index File No. N-7

CORNER RECORD (SEARCH)
(Ref. FSM 7151.4)

Tract or Survey No. _____ Cor. No. _____

T 2S R. 35E R.D. Ukiah County Umatilla
Merid. W.M. N.F. Umatilla State Or.

CORNER DIAGRAM

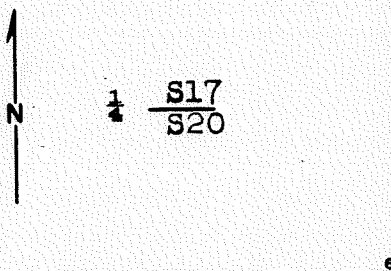

DESCRIBE CORNER MONUMENT FOUND
None.

DESCRIBE BEARING TREES OR OTHER OFFICIAL ACCESSORIES FOUND
None.

PHOTO IDENTIFICATION DATA

Photo No. _____
Filed At. _____
Object Ident. _____
Ident. By _____
Signature

DESCRIBE CORNER LOCATION RELATIVE TO NEAR-BY FEATURES, ALSO HOW TO REACH CORNER
Cor. falls on gentle N slope, S of fence in second growth W. fir, spruce & tamarack. From section cor. to the W follow posted property line E $\frac{1}{2}$ mi.

PLANE COORDINATE POSITION DATA

State _____ Zone _____
X _____
Y _____
Estab. By _____
Agency

Signature
F. L. Munro

Title L.S. Division _____ Headquarters _____ Date 9/26/84 7100-52-(3,68)

CORNER RECORD (PERPETUATION)

MONUMENT: DESCRIBE NEW MONUMENT SET, OR WORK DONE TO PRESERVE EXISTING MONUMENT

2½"x30" alum. pipe with 3" alum. cap mkd:

T2S R35E
 ¼ $\frac{S17}{S20}$
 PLS 1832
 1984

ACCESSORIES : DESCRIBE NEW BT'S WITNESS OBJECTS ETC. ESTABLISHED, OR WORK DONE TO PRESERVE EXISTING EVIDENCE

W. fir, 6", N44°E, 12.5 ft.
 Spruce, 7", S52½°W, 50.2 ft.

BTs have reqd. paint, tags & signs.

Work Done By F. S. Munro Title L. S. Date 9/8/84 State Registration No. _____
 or Agency _____
 Certified Cor. Record Prepared? Yes No Filed At: Umatilla Co. Surveyor Date _____

REMARKS

Index File No. N-7 T. 2S R. 35E M. W.M. Tract or Surv. No. _____ Cor _____