

Index

File No. _____

T 2S R. 35E

Merid. _____

CORNER RECORD (SEARCH)

(Ref. FSM 7151.4)

R.D. UKIAT

N.F. Umatilla

Tract or

Survey No. UIR


Cor.

No. 59

County Umatilla

State Or

CORNER DIAGRAM

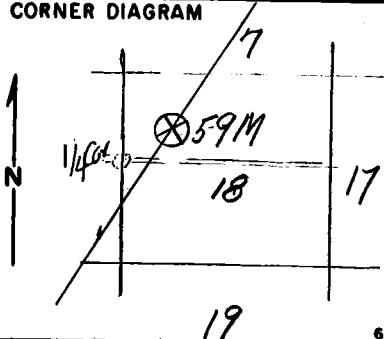

DESCRIBE CORNER MONUMENT FOUND

Could not identify key Rock
From a large mound of rocks
(Should be re-checked)

DESCRIBE BEARING TREES OR OTHER OFFICIAL ACCESSORIES FOUND

None Found

PHOTO IDENTIFICATION DATA

Photo No. _____

Filed At. _____

Object Ident. _____

Ident. By _____

Signature

PLANE COORDINATE POSITION DATA

State _____ Zone _____

X _____

Y _____

Estab. By _____

Agency

Signature *Lecky*

Title _____

Division _____

Headquarters _____

Date 8/3

CORNER RECORD (PERPETUATION)

MONUMENT : DESCRIBE NEW MONUMENT SET, OR WORK DONE TO PRESERVE EXISTING MONUMENT

ACCESSORIES : DESCRIBE NEW BT'S WITNESS OBJECTS ETC. ESTABLISHED, OR WORK DONE TO PRESERVE EXISTING EVIDENCE

Work Done By _____ Title _____ Date _____ State Registration No. _____
or Agency _____
Certified Cor. Record Prepared ? Yes No Filed At _____ Date _____

REMARKS

Index File No. T. R. M. Tract or Surv. No. Cor.