

**OREGON CORNER RESTORATION FORM**


Section 14 Township 3N Range 27E  
 County Umatilla Date 06-29-08

Corner Designation: 3N27E24

Condition Report Only  
 Not Found  
 Remonumented  
 Unrecorded  
 Surveyed In  
 Referenced Out

Previous Renewals / Surveys, etc.  
 Survey 90-49-B reported finding a 2 1/2" brass cap on a 1 3/4" pipe here as set by Gould in 1940.

Monument and Accessories Found: (Location and source)  
 Found standard GLO brass cap on an iron pipe between irrigation circle roads. Pipe is bent 14" down. Brass location at apparent center of lower part of pipe.

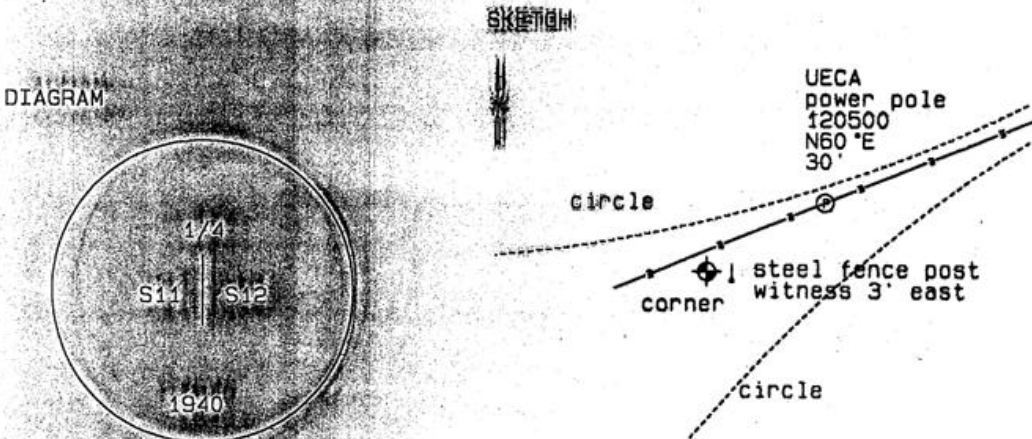

**MONUMENT (S) AND ACCESSORIES SET (Procedures and Description)**

None.

**REFERENCES SET**

None.  
 Made GPS tie to TRM Station Stanfield East Base  
 Latitude: 45 45 20.4627 N  
 Longitude: 119 29 35.6990 W  
 NAD: 83 (1994)

Oregon State Plane Coord. - North Zone	
Northing	763546.32
Easting	8484586.44
Ortho Height	729.71
Ellipsoidal Height	659.86

Location and Comments: Compass Declination 20°E Surveyors Seal

From junction of 184 and Westland Road, follow Coll Jordan Road south 1.1 mile. Enter the posted Madison Farm Road and continue south 0.7 mile. The follow a circle road south westerly 1.3 mile to the corner on the southeast side of the road.

REGISTERED PROFESSIONAL LAND SURVEYOR

RECEIVED BY:

David L. Haddock  
 Haddock Surveying  
 P.O. Box 4674  
 Pendleton, OR 97001  
 (541) 876-2474

*David L. Haddock*

Date: 12-02  
 Rec'd By: KL  
 No: 02-282-19

OREGON  
 JULY 12, 1968  
 DAVID L. HADDOCK  
 852