

OREGON CORNER RESTORATION FORM


Section 15 Township 3N Range 27E
 County Umatilla Date: 07-20-02
 Corner Designation: 3N27J43

Condition Report Only
 Not Found
 Remonumented
 Unrecorded
 Surveyed In
 Referenced Out

Previous Renewals / Surveys, etc.
 Survey 90-49-B found a 1940 GI-0 brass cap here.

Monument and Accessories Found: (condition and source)

Found the above brass cap in good condition.

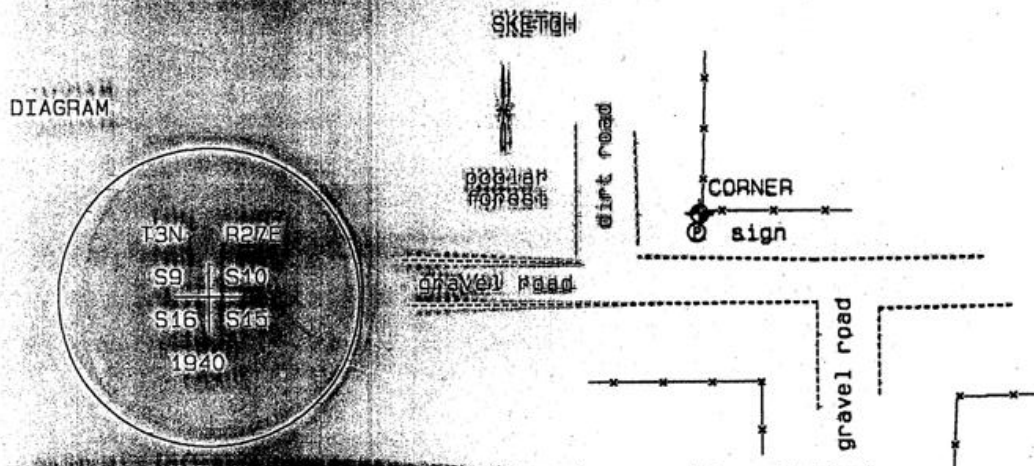

MONUMENT (S) AND ACCESSORIES SET (Procedures and Description)

None

REFERENCES SET

None

Made GPS tie to TRI Station
 Stanfield East Base
 Latitude 45 24 53 N 51627.1
 Longitude 119 26 04 W 85324.1
 NAD 83 (1991)

Oregon State Plane Coord. - North Zone
 Northing 760677.86
 Easting 8474047.65
 Ortho Height 653.58
 Ellipsoidal Height 583.73

Location and Comments: Compass Orientation 20°E
 From the junction of Hill and Westland Road, follow Jordan Road south 4.4 miles. Enter the posted Madison Farm Road and continue south 0.7 mile. Then follow circle roads south westerly 2.6 miles to a pumping station easily visible on the hill. From the pumping station, follow a gravel road west for 1/2 mile. The corner is on the north side of the road at the intersection of a fence from the north and a fence from the east.

Surveyors Seal

REGISTERED
 PROFESSIONAL
 LAND SURVEYOR

David L. Haddock

OREGON
 JULY 12, 1968
 DAVID L. HADDOCK
 852

RENEWS 6-30-03

RECEIVED BY:

Firm / Agency

Date: 12-02
 Rec'd By: KE
 No: 02-2829

Haddock Surveying
 P. O. Box 1874
 Pendleton, OR 97801
 (541) 278-2174