

OREGON CORNER RESTORATION FORM

Section 23 Township 3N Range 27E
 County Umatilla Date 08-10-02

Corner Designation: 3N27R17

Condition Report Only
 Not Found
 Remonumented
 Unrecorded
 Surveyed In
 Referenced Out



Previous Renewals / Surveys, etc.

Corner set by Gould of GLO in 1940.
 Survey 82-115-AX reports finding this monument.

Monument and Accessories Found (condition and source)

Found the record monument in good condition 6 inches up from the surface, stamped as shown in the diagram below.

DIAGRAM

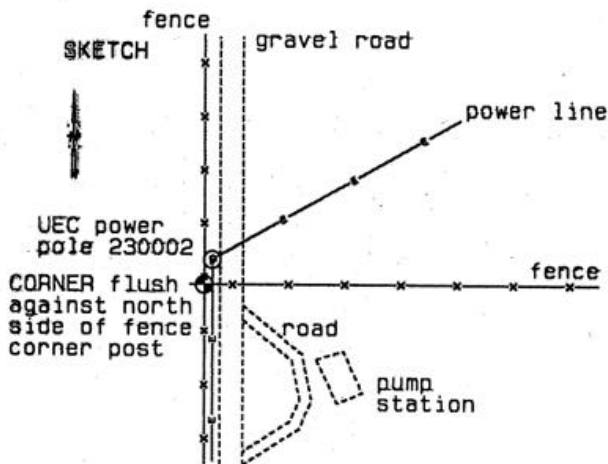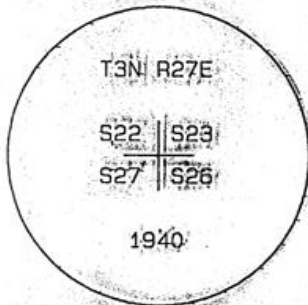

MONUMENT (S) AND ACCESSORIES SET (Procedures and Description)

None.

REFERENCES SET:

None.

Made GPS tie to TPI Station
 Stanfield East Base
 Latitude 45 29 09.94530 N
 Longitude 119 24 50.88990 W
 NAD 83 (1991)

Oregon State Plane Coord. - North Zone
 Northing 750258.84
 Easting 8479468.70
 Ortho Height 911.74
 Ellipsoidal Height 842.08

Location and Comments Compass Declination 20°E

Surveyors Seal

From the junction of Highways 320 and 207, follow Madison Farm Road west 1.1 miles. Then follow the south side of Madison Farm Road south west 0.9 mile to a fence corner. Go north along the fence 1 mile to the corner at a fence corner.

REGISTERED
 PROFESSIONAL
 LAND SURVEYOR

RECEIVED BY:

Firm / Agency

David L. Haddock

Date: 12-10-02
 Rec'd By: RK
 No: 02-282-91

Haddock Surveying
 P. O. Box 1574
 Pendleton, OR 97801
 (541) 278-2174

OREGON
 JULY 12, 1968
 DAVID L. HADDOCK
 852

RENEWS 6-30-03