

**OREGON CORNER RESTORATION FORM**

Section 1 Township 3N Range 28E  
 County Umatilla Date: 06-14-02

Corner Designation: 3N28A23


_____	Condition Report Only
_____	Not Found
_____	Re monumented
_____	Unrecorded
<u>x</u> _____	Surveyed In
_____	Referenced Out

Previous Renewals / Surveys, etc.  
 This corner was set under survey S-156-C.

Monument and Accessories Found: ( condition and source )

Found a witness corner stamped as shown in the diagram.

DIAGRAM

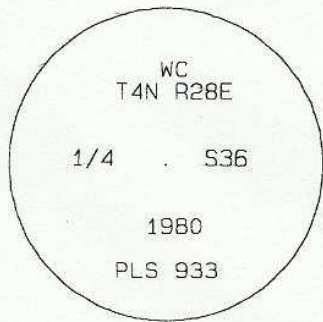

SKETCH




RR tie  
 N1°47'W,  
 52.8'  
 RR tie  
 N15°03'W  
 46.8'

Edelman Lane

RR tie  
 N23°37'E  
 57.3'

Note:  
 Bearings  
 and distances  
 are to east  
 witness corner.

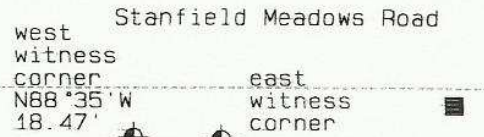

MONUMENT (S) AND ACCESSORIES SET (Procedures and Description)

None.

REFERENCES SET:

None.

Made GPS tie to TRI Station  
 Stanfield East Base.  
 Latitude 45°46'36.91874"N  
 Longitude 119°15'32.07250"W  
 NAD 83(1991)  
 Coordinates are for east  
 witness corner.

Oregon State Plane Coord. - North Zone  
 Northing 771790.57  
 Easting 8518753.58  
 Ortho Height 574.01  
 Ellipsoidal Height 504.26

Location and Comments      Compass Declination      Surveyors Seal  
 20 °E

Exit I84 at Echo Meadows Road. Go north 0.6 miles to Stanfield Meadows Road. Go west on Stanfield Meadows Road 1.0 miles. Witness corner is on south side of near base of railroad tie in fence line.

REGISTERED  
 PROFESSIONAL  
 LAND SURVEYOR

RECEIVED BY:

Firm / Agency

*David L. Haddock*

Date: 7-02  
 Rec'd By: KK  
 No. 02-185-9

Haddock Surveying  
 P. O. Box 1574  
 Pendleton, OR 97801  
 (541) 276-2174

OREGON  
 JULY 12, 1968  
 DAVID L. HADDOCK  
 852

RENEWS 6-30-03