

OREGON CORNER RESTORATION FORM

Section 6,7 Township 3N
County Umatilla Date: 09/22/09

Range 29E

Corner Designation: 3N29E1

Corner common to sections 6 and 7, T3NR29E, 1 and 12, T3NR28E.

_____	Condition Report Only
<u> X </u>	Not Found
<u> X </u>	Remonumented
_____	Unrecorded
<u> X </u>	Surveyed In
<u> X </u>	Referenced Out


Previous Renewals / Surveys, etc.

Originally Surveyed by N.H. Gates in 1859. He set a post in a mound of earth.


Monuments and Accessories Found: (Condition and Source)

None.

Diagram

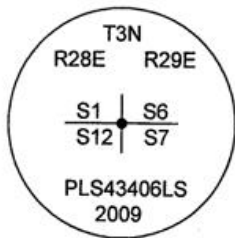

Sketch

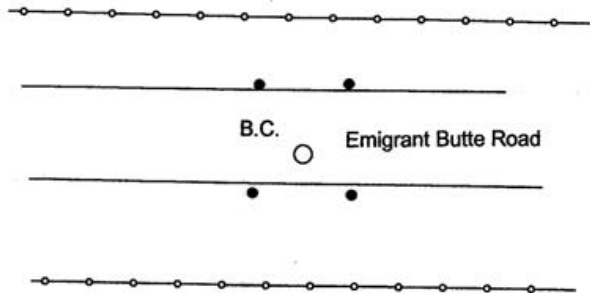

NAD 83/91
OREGON STATE PLANE NORTH
INTERNATIONAL FEET

N766467.86
E8521486.95

LAT - 45° 45' 43.95849" N
LON - 119° 14' 54.67444" W

Monument (s) Set (Procedures and Description)

A 1 1/2" X 30" galvanized iron pipe with 2 1/2" brass cap, by single proportionate methods along the township line and the projection of the South line of Section 6. Corner position falls in the Emigrant Butte Road.

References Set:

- A 1/2" x 30" Iron rebar w/rpc #43406 lies N 49°45' E, 29.04'.
- A 1/2" x 30" Iron rebar w/rpc #43406 lies N 35°15' W, 25.65'.
- A 1/2" x 30" Iron rebar w/rpc #43406 lies S 51°45' W, 19.17'.
- A 1/2" x 30" Iron rebar w/rpc #43406 lies S 52°00' E, 19.75'.

Location and Comments

The corner is .5 miles West from the intersection of Echo Meadows Road and Emigrant Butte Road.

Compass Declination
17° E

Surveyors Seal

REGISTERED
PROFESSIONAL
LAND SURVEYOR

Robert D. English
OREGON
JANUARY 11, 2005
ROBERT DOUGLAS ENGLISH
43406LS

RENEWAL DATE: 12/31/09

RECEIVED BY:

Date: 1-11
Rec'd By: KK
No. 11-10-B

Firm / Agency

Survey One, LLC.
P.O. Box 382
Pendleton, OR 97801
(541) 276-2055