

OREGON CORNER RESTORATION FORM

COUNTY: Umatilla. DATE: 03/06/23.

CORNER DESIGNATION: E-3, the South Quarter corner of Section 6, Township 3 North, Range 28 East, W.M.

PREVIOUS RENEWALS/SURVEYS ETC: Corner was originally established by N.H. Gates under Contract No. 84, dated July 22, 1859. Gates set a post in earth mound. Survey Number 198, (1904) found in Record of Private Survey Books, reestablished the corner and set a long necked bottle and stove castings for the corner. Survey No. 13-015-C recovered a 3/4" smooth rod at the corner point.

MONUMENT AND ACCESSORIES FOUND: Found a 5/8" smooth rod, slightly bent, 6' East of fence corner with old posts, (no wire), extending North, East and South. Dug alongside smooth rod in attempt to find long necked bottle and stove castings reported on Survey No. 198, but found nothing.

MONUMENT MARKING DETAIL:

T3N R28E
S6
1/4 -----
S7
2023
PLS 54657

NEW MONUMENT SET:

At a base of the slightly bent smooth rod, set a 2 1/2" brass cap on 1 1/4 by 30" galvanized iron pipe 28" in the ground, marked as shown in Monument Marking Detail. Nailed Witness Post Sign to railroad tie fence corner North of corner monument. Buried the smooth rod on South side of new monument 10" below ground.

New accessories:

A 5/8"X24" rebar with blue plastic cap marked "Wells Surveying 54657PLS" bears S 87°49'32" E, 25.58', beside post in fence line East.

A 5/8"X24" rebar with blue plastic cap marked "Wells Surveying 54657PLS" bears S 05°01'48" W, 58.27' beside post in fence line South.

A 5/8"X24" rebar with blue plastic cap marked "Wells Surveying 54657PLS" bears S 19°51'30" W, 36.18', 1' East of UECA pole #074998.

A 5/8"X24" rebar with blue plastic cap marked "Wells Surveying 54657PLS" bears N 05°52'36" W, 83.66', beside post in fence line North.

Attached bearing object signs to posts or power pole near each accessory.

Courses to corner accessories are State Plane Grid bearings and distances.

LOCATION AND COMMENTS:



OREGON STATE PLANE COORDINATE, North Zone NAD 83(91), International Feet Units:

N: 766277.80
E: 8492263.93

FIRM: Wells Surveying
P.O. Box 1696
Pendleton, OR 97801

Surveyor's Seal

\3N28E-3

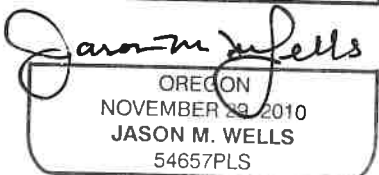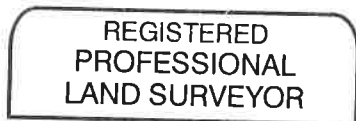

RENEWS: 6:30:24

24-004-C