

OREGON CORNER RESTORATION FORM

Section 24 Township 3N Range 27E
 County Umatilla Date 06-27-02

Corner Designation: 3N27N25


<input checked="" type="checkbox"/> <u> </u> <input type="checkbox"/> <u> </u> <input type="checkbox"/> <u> </u> <input type="checkbox"/> <u> </u> <input type="checkbox"/> <u> </u>	Condition Report Only Not Found Remonumented Unrecorded Surveyed In Referenced Out
---	---

Previous Renewals / Surveys, etc.
 The GLO set a corner here in 1940.
 Survey S-90-B reports finding that monument:


Monument and Accessories Found: (condition and source)

Found the monument as described below part to northeast.

DIAGRAM

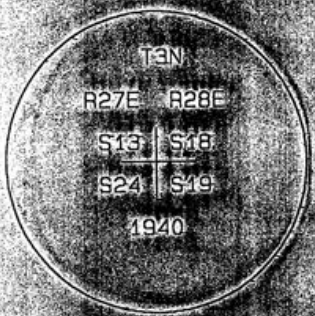

SKETCH

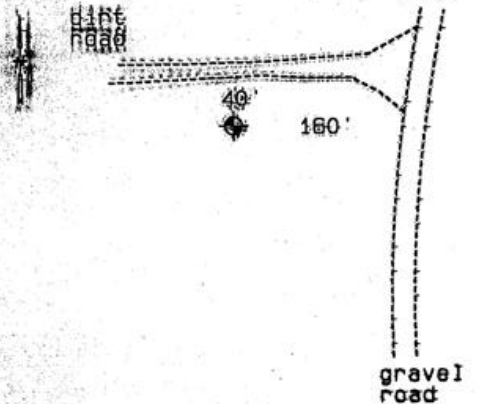

MONUMENT (S) AND ACCESSORIES SET (Procedures and Description)

None.

REFERENCES SET

None.

Made GPS tie to TPI Station
 Stanfield East Base
 Latitude 45 44 04.202 N
 Longitude 119 22 20.9855 W
 NAD 83 (1991)

Oregon State Plane Coord. - North Zone
 Northing 760973.77
 Easting 8489935.29
 Ortho Height 694.77
 Ellipsoidal Height 624.96

Location and Comments Compass Orientation 20°E Surveyors Seal

From the Jct of 184 with Westland Road,
 go south 1.4 miles then go south on the Madison Farm
 circle roads 3.5 mile to the corner.

RECEIVED BY

Date: 12-02
 Rec'd By: RE
 No: 02-28239

Firm / Agency

Haddock Surveying
 P. O. Box 1874
 Pendleton, OR 97801
 (541) 278-2174

REGISTERED
 PROFESSIONAL
 LAND SURVEYOR

David L. Haddock

OREGON
 JULY 12, 1968
 DAVID L. HADDOCK
 652

RENEWS 6-30-03