

OREGON CORNER RESTORATION FORM

COUNTY: Umatilla. DATE: 02/09/23.

CORNER DESIGNATION: N-13, the Northeast Corner of Section 21, Township 3 North, Range 28 East, W.M.

PREVIOUS RENEWALS/SURVEYS ETC: Corner was originally established by N.H. Gates under Contract No. 84, dated July 22, 1859. Gates set a post in earth mound. Survey No. 262 found in Record of Private Survey Books, calls for an Iron pipe for this corner in 1908. Survey No. H-107-B recovers an iron pin 12" underground and remonuments with a brass cap on iron pipe monument in 1972. Subsequent record surveys have used the brass cap per Survey No. H-107-B.

MONUMENT AND ACCESSORIES FOUND: Found 2 1/2" brass cap, 22" below ground level with steel fence post and old Witness Post sign, 3" West of monument, stamped as shown in Monument Marking Detail.

MONUMENT MARKING DETAIL:

T3N R28E
S16|S15
S21|S22
1972

MAINTAINED CORNER MONUMENT:

New accessories:

- A 5/8"X24" rebar with blue plastic cap marked "Wells Surveying 54657PLS" bears N 37°32'01" E, 22.54', in unfarmed field corner. Wired bearing object sign to rebar.
- A 5/8"X24" rebar with blue plastic cap marked "Wells Surveying 54657PLS" bears S 13°36'56" W, 19.26', in unfarmed field corner. Wired bearing object sign to rebar.
- A blue Deep-1 magnet buried 22" in the ground bears S 50°11'50" W, 53.56', in unfarmed CRP field. Buried bearing object sign with magnet.
- A orange Deep-1 magnet buried 22" in the ground bears N 66°02'33" W, 54.98', in unfarmed CRP field. Buried bearing object sign with magnet.

Attached Witness Post sign to UECA pole no. 3N28E150001, 5'+/- North of monument. There is an existing bearing object sign on this pole circa 2002 stating the corner is 4.5' South.

Courses to corner accessories are State Plane Grid bearings and distances.

LOCATION AND COMMENTS: Corner falls S 33° E, 36'+/- from the intersection of a 4 way field road intersection, and 5'+/- South of existing UECA power pole.


OREGON STATE PLANE COORDINATE, North Zone NAD 83(91), International Feet Units:

N: 755633.99
E: 8505768.86

FIRM: Wells Surveying
P.O. Box 1696
Pendleton, OR 97801

Surveyor's Seal

\3N28N-13

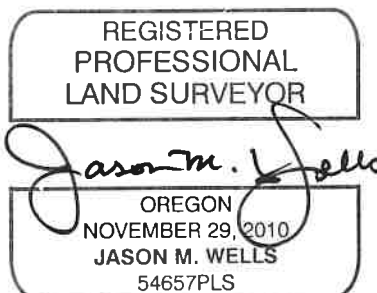

RENEWS: 6! 30! 24

24-004-C