

OREGON CORNER RESTORATION FORM

Section 31
County Umatilla

Township 3N
Date: 09/22/09

Range 29E

Corner Designation: 3N29X1

1/4 corner common to sections 31, T3NR29E, and 36, T3NR28E.

- Condition Report Only
- Not Found
- Remonumented
- Unrecorded
- Surveyed In
- Referenced Out


Previous Renewals / Surveys, etc.

Originally Surveyed by N.H. Gates in 1859. He set a post in a mound of earth.


Monuments and Accessories Found: (Condition and Source)

None.

Diagram

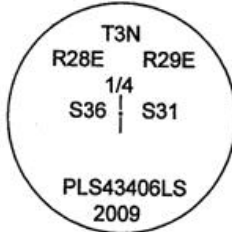

Sketch

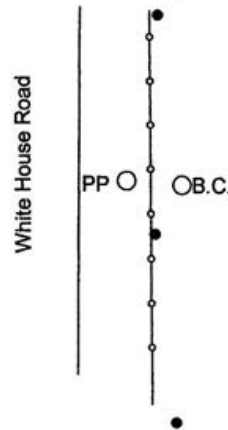

NAD 83/91
OREGON STATE PLANE NORTH
INTERNATIONAL FEET

N742542.89
E8521873.95

LAT - 45° 41' 47.71197" N
LON - 119° 14' 54.43717" W

Monument (s) Set (Procedures and Description)

A 1 1/2" X 14" galvanized Iron pipe with 2 1/2" Brass Cap, by single proportionate methods, holding the fence intersection at the Northwest corner of Section 31 for Northing and line between found monuments for Easting.

References Set:

- A 3/8" x 30" Iron rebar w/ypc #43406 at wooden gate post, lies N 2°00' W, 43.66'.
- A 3/8" x 30" Iron rebar w/ypc #43406 at steel fence post, lies S 35°00' W, 6.84'.
- A 3/8" x 30" Iron rebar w/ypc #43406 at wooden fence post, lies S 7°30' W, 51.24'.
- A pk nail w/ brass washer #43406 on power pole, lies N 89°00' W, 5.91'.

Location and Comments

The corner is 2 miles South of the intersection of Hwy. 320 and Whitehouse Road, on Whitehouse Road.

Compass Declination

17° E

Surveyors Seal

REGISTERED
PROFESSIONAL
LAND SURVEYOR

Robert D. English
 OREGON
 JANUARY 11, 2005
 ROBERT DOUGLAS ENGLISH
 43406LS

RENEWAL DATE: 12/31/09

RECEIVED BY:

Date: 10-09
 Rec'd By: RE
 No. 09-146-R

Firm / Agency

Survey One, LLC.
 P.O. Box 382
 Pendleton, OR 97801
 (541) 276-2055