

OREGON CORNER RESTORATION FORM

Section 3,4 Township 3N
County Umatilla Date: 08/12/10

Range 29E

Corner Designation: 3N29C13

Corner common to sections 3,4 T3NR29E.

- Condition Report Only
- Not Found
- Remonumented
- Unrecorded
- Surveyed In
- Referenced Out


Previous Renewals / Surveys, etc.

Originally Surveyed by Gates. He set a post in a mound of earth in 1859.

Monuments and Accessories Found: (Condition and Source)


Found a stone 20"x6"x5", buried vertically at the fence intersecion.

Diagram

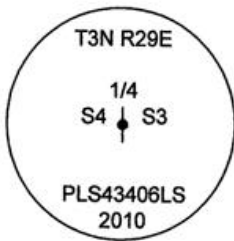

5/8" Iron Rebar

Sketch

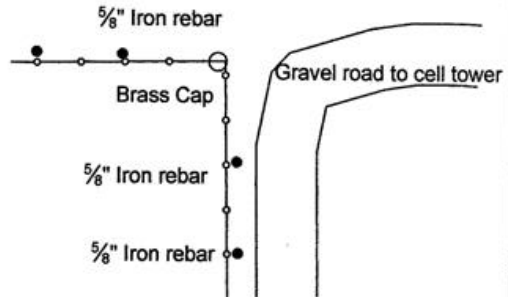

NAD 83/91
OREGON STATE PLANE NORTH
INTERNATIONAL FEET

N769457.11
E8537832.36

LAT - 45° 46' 10.90333" N
LON - 119° 11' 03.45676" W

Monument (s) Set (Procedures and Description)

A 1 1/4" x 30" galvanized iron pipe with a 2 1/2" brass cap, stamped as shown above.

References Set:

- A 5/8" x 30" Iron rebar w/rpc #43406 lies N 86°30' W, 29.45'.
- A 5/8" x 30" Iron rebar w/rpc #43406 lies N 87° W, 13.63'.
- A 5/8" x 30" Iron rebar w/rpc #43406 lies S 4°30' E, 23.20'.
- A 5/8" x 30" Iron rebar w/rpc #43406 lies S 3° E, 40.33'.

Location and Comments

There is a farm access road that goes out to a cell tower and runs between active farm fields 1/2 mile South of Stage Gulch Road.

Compass Declination
17° E

Surveyors Seal

REGISTERED
PROFESSIONAL
LAND SURVEYOR

Robert Douglas English
OREGON
JANUARY II, 2005
ROBERT DOUGLAS ENGLISH
43406LS

RECEIVED BY:

Date: 1-11
Rec'd By: KE
No. 11-09-R

Firm / Agency

Survey One, LLC.
P.O. Box 382
Pendleton, OR 97801
(541) 276-2055

RENEWAL DATE: 12/31/11