

OREGON CORNER RESTORATION FORM

Section 3 Township 3N
County Umatilla Date: 09/08/09

Range 29E

Corner Designation: 3N29E17

Corner common to sections 2,3,10 and 11, T3NR29E.

- Condition Report Only
- Not Found
- Remonumented
- Unrecorded
- Surveyed In
- Referenced Out

Previous Renewals / Surveys, etc.

Originally Surveyed by N.H. Gates in 1859. He set a post in a mound of earth w/ charcoal.

D. Haddock set a 2 1/4" Brass Cap at a fence intersection on survey 98-155-C, in 04/1998.

D. Haddock found the Brass Cap, in 05/2002.

Monuments and Accessories Found: (Condition and Source)

A 2.5" B.C.


A 5/8" Iron rebar w/rpc #852 under the fence lies N 89° 30' W, 71.00'.

A 5/8" Iron rebar w/rpc #852 under the fence lies S 00°45' E, 61.77'.


A 5/8" Iron rebar w/rpc #852 under the fence lies S 01°45' E, 32.04'.

A 5/8" Iron rebar w/rpc #852 under the fence lies N 89°00' W, 35.48'.

Diagram

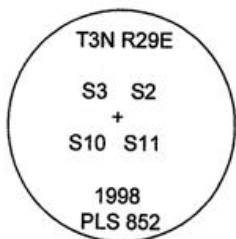

Sketch

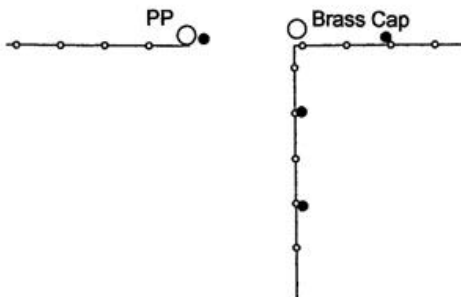

NAD 83/91
OREGON STATE PLANE NORTH
INTERNATIONAL FEET

N766945.60
E8543227.69

LAT - 45° 45' 45.23655" N
LON - 119° 09' 47.93891" W

Monument (s) Set (Procedures and Description)

None.

References Set:

None.

Location and Comments

The corner 1.5 miles East from the South end of S. Ash Road, on a gravel road.

Compass Declination
17° E

Surveyors Seal

REGISTERED
PROFESSIONAL
LAND SURVEYOR

Robert D. English
OREGON
JANUARY II, 2005
ROBERT DOUGLAS ENGLISH
43406LS

RECEIVED BY:

Date: 1-11
Rec'd By: KK
No. 11-10-R

Firm / Agency

Survey One, LLC.
P.O. Box 382
Pendleton, OR 97801
(541) 276-2055

RENEWAL DATE: 12/31/09