

OREGON CORNER RESTORATION FORM

Section 1,2,11,12 Township 3N
County Umatilla Date: 08/20/10

Range 29E

Corner Designation: 3N29E21

Corner common to sections 1,2,11 and 12, T3NR29E.

- Condition Report Only
- Not Found
- Remonumented
- Unrecorded
- Surveyed In
- Referenced Out


Previous Renewals / Surveys, etc.

Originally Surveyed by N.H. Gates in 1859. He set a post in a mound of earth w/ charcoal.


Monuments and Accessories Found: (Condition and Source)

None.

Diagram

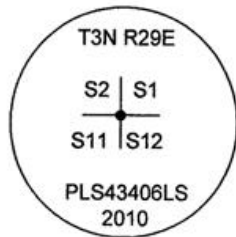

Sketch

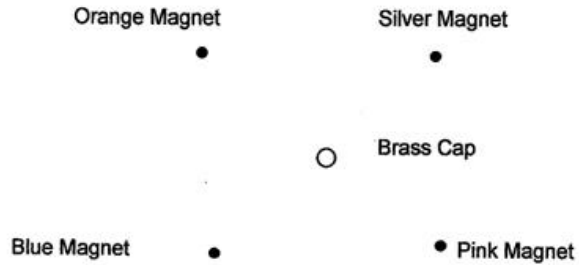

NAD 83/91
OREGON STATE PLANE NORTH
INTERNATIONAL FEET

N767070.36
E8548510.47

LAT - 45° 45' 45.59859" N
LON - 119° 08' 33.40273" W

Monument (s) Set (Procedures and Description)

A 1 1/4" x 30" galvanized iron pipe with a 2 1/2" brass Cap, 18" below surface, stamped as shown above, set by double proportionate method.

References Set: "Deep One" magnets by Berntsen.

- An Orange magnet 22" deep, lies N 31°00' W, 15.53'.
- A Silver magnet 23" deep, lies N 46°15' E, 17.75'.
- A Pink magnet 23" deep, lies S 46°15' E, 19.38'.
- A Blue magnet 22" deep, lies S 46°10' W, 17.46'.

Location and Comments

The corner is in a wheat field in the East edge of a pivot, appx. 300 feet West of a farm road.

Compass Declination
17° E

Surveyors Seal

REGISTERED
PROFESSIONAL
LAND SURVEYOR

Robert D. English
OREGON
JANUARY 11, 2005
ROBERT DOUGLAS ENGLISH
43406LS

RECEIVED BY:

Date: 1-11
Rec'd By: KE
11-10-R

Firm / Agency

Survey One, LLC.
P.O. Box 382
Pendleton, OR 97801
(541) 278-2055

RENEWAL DATE: 12/31/11