

**OREGON CORNER RESTORATION FORM**

Section 8,9

Township 3N

Range 29E

County Umatilla

Date: 09/15/09

Corner Designation: 3N29G9

Corner common to sections 8 and 9, T3NR29E.

_____	Condition Report Only
X _____	Not Found
X _____	Remonumented
_____	Unrecorded
X _____	Surveyed In
X _____	Referenced Out


**Previous Renewals / Surveys, etc.**

Originally Surveyed by Gates in 1859. He set a post in a mound of earth.  
 Kimbrell set a cedar post over stone coal with stone coal witness marks in private surveys book 1, page 582.  
 Krumbain established a point for this corner in 1974, survey #98-11-B.  
 Krumbain found a wagon axle at this point in 1981, and set a brass cap.  
 D. Haddock set a 2 1/4" brass cap at the road intersection of the North-South section line and the East-West centerline of Bowman Road, which came to the quarter corner according to the county road notes.


**Monuments and Accessories Found: (Condition and Source)**

Found a 2 1/2" Brass cap set by Haddock.  
 Found a 5/8" Iron rebar w/rpc #852 lies S 26°30' W, 68.49'.

Diagram

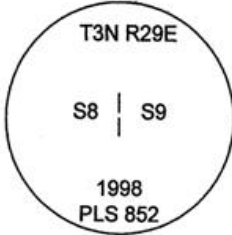

Sketch

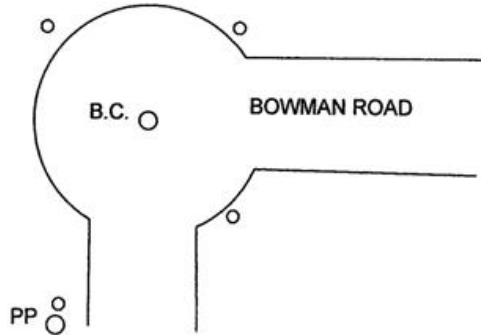

NAD 83/91  
 OREGON STATE PLANE NORTH  
 INTERNATIONAL FEET

N764081.67  
 E8532750.71

LAT - 45° 45' 18.65000" N  
 LON - 119° 12' 16.35253" W

**Monument (s) Set (Procedures and Description)**

None.

**References Set:**

- A 5/8" Iron rebar w/ypc #43406 lies N 43°45' E, 31.84'.
- A 5/8" Iron rebar w/ypc #43406 lies S 37°15' E, 27.28'.
- A 5/8" Iron rebar w/ypc #43406 lies N 48°45' W, 40.96'.

**Location and Comments**

The monument is at the very West end of the Bowman Road, in the middle of the culdesac.

**Compass Declination**

17° E

**Surveyors Seal**

REGISTERED  
 PROFESSIONAL  
 LAND SURVEYOR

*Robert D. English*  
 OREGON  
 JANUARY 11, 2005  
 ROBERT DOUGLAS ENGLISH  
 43406LS

RENEWAL DATE: 12/31/09

**RECEIVED BY:**

Date: 1-11  
 Rec'd By: KK  
 No. 11-12-2

**Firm / Agency**

Survey One, LLC.  
 P.O. Box 382  
 Pendleton, OR 97801  
 (541) 276-2055