

OREGON CORNER RESTORATION FORM

Section 10 Township 3N
County Umatilla Date: 09/08/09

Range 29E

Corner Designation: 3N29J17

Corner common to sections 10,11,14 and 15, T3NR29E.

- Condition Report Only
- Not Found
- Remonumented
- Unrecorded
- Surveyed In
- Referenced Out


Previous Renewals / Surveys, etc.

Originally Surveyed by N.H. Gates in 1859. He set a post in a mound of earth w/ charcoal.
S. Haddock set a PK Nail in the centerline of Hwy. 320 with a Brass Cap witness corner.


Monuments and Accessories Found: (Condition and Source)

- A 2.5" B.C.
- A 2.5" Brass Cap witness corner lies
- A 1/2" Iron rebar w/opc #56295 1 foot underground lies N 63° 30' E, 73.32'.
- A 1/2" Iron rebar w/rpc #56295 1 foot underground lies N 34°00' W, 31.20'.
- A 1/2" Iron rebar w/ypc #56295 at sign post lies S 01°00' E, 30.42'.

Diagram

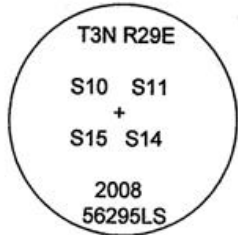

Sketch

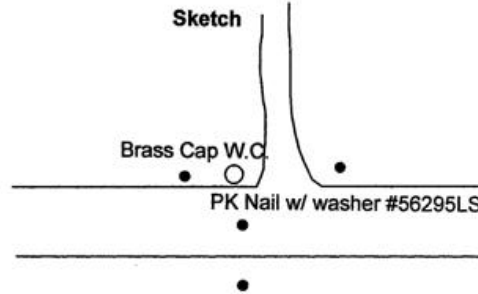

NAD 83/91
OREGON STATE PLANE NORTH
INTERNATIONAL FEET

N761671.09
E8543325.81

LAT - 45° 44' 53.15299" N
LON - 119° 09' 47.78600" W

Monument (s) Set (Procedures and Description)
None.

References Set:
None.

Location and Comments
The corner 1 mile East of
Echo on Hwy. 320.

Compass Declination
17° E

Surveyors Seal

REGISTERED
PROFESSIONAL
LAND SURVEYOR

Robert D. English
OREGON
JANUARY 11, 2005
ROBERT DOUGLAS ENGLISH
43406LS

RENEWAL DATE: 12/31/09

RECEIVED BY:

Date: 1-11
Rec'd By: KK
No. 11-12-R

Firm / Agency

Survey One, LLC.
P.O. Box 382
Pendleton, OR 97801
(541) 276-2055