

OREGON CORNER RESTORATION FORM

Section 11,12,13,14 Township 3N
County Umatilla Date: 05/06/10

Range 29E

Corner Designation: 3N29J21

Corner common to section 11,12,13 and 14 T3NR29E.

_____	Condition Report Only
X_____	Not Found
X_____	Remonumented
_____	Unrecorded
X_____	Surveyed In
X_____	Referenced Out

Previous Renewals / Surveys, etc.


Originally Surveyed by Gates in 1859. He set a post in a mound of earth.

Monuments and Accessories Found: (Condition and Source)

None.


Sketch

Diagram

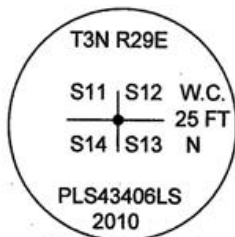

W.C.
NAD 83/91
OREGON STATE PLANE NORTH
INTERNATIONAL FEET

N761789.58
E8548622.43
LAT - 45° 44' 53.45078" N
LON - 119° 08' 33.07515" W

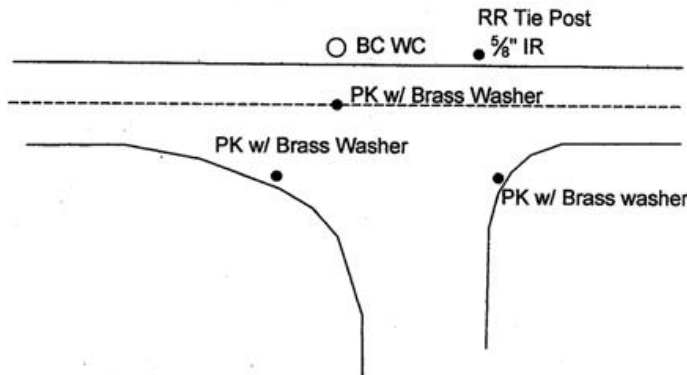

Monument (s) Set (Procedures and Description)

A pk nail w/ 1 1/2" Brass washer stamped 43406LS, w/ WC to North. Set corner by Double Proportionate Method and fit Hwy. 320 very well.

References Set:

- A 5/8" x 30" Iron rebar w/rpc #43406 lies N 62°40' E, 73.44'.
- A pk nail w/ 1 1/2" Brass washer #43406 lies S 59° E, 77.69'.
- A pk nail w/ 1 1/2" Brass washer #43406 lies S 45°15' W, 28.51'.
- 1 1/2" x 30" galvanized iron pipe with a 2 1/2" brass cap monument Witness Corner, stamped as shown above, lies N 0°10' W, 25.00'

Location and Comments

The corner is 1.0 miles West of the intersection of Coppinger Lane and Hwy. 320. on Hwy. 320.

Compass Declination
17° E

Surveyors Seal

REGISTERED
PROFESSIONAL
LAND SURVEYOR

Robert D. English
OREGON
JANUARY 11, 2005
ROBERT DOUGLAS ENGLISH
43406LS

RENEWAL DATE: 12/31/11

RECEIVED BY:

Date: 1-11
Rec'd By: KK
No. 11-13-R

Firm / Agency

Survey One, LLC.
P.O. Box 382
Pendleton, OR 97801
(541) 276-2055