

OREGON CORNER RESTORATION FORM

Section 18,19 Township 3N
County Umatilla Date: 01/17/11

Range 29E

Corner Designation: 3N29N3

Corner common to sections 18 and 19, T3NR29E.



- Condition Report Only
- Not Found
- Remonumented
- Unrecorded
- Surveyed In
- Referenced Out

Previous Renewals / Surveys, etc.

Originally Surveyed by N.H. Gates in 1859. He set a post in a mound of earth.

Monuments and Accessories Found: (Condition and Source)

None.

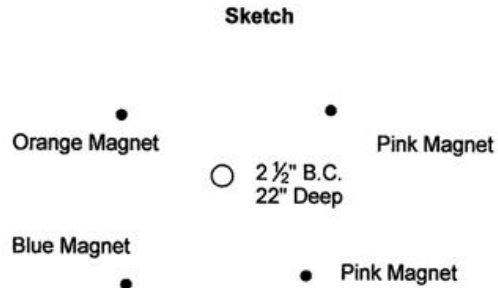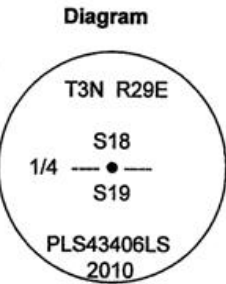

NAD 83/91
OREGON STATE PLANE NORTH
INTERNATIONAL FEET

N755977.67
E8524841.00

LAT - 45° 43' 59.88668" N
LON - 119° 14' 09.68432" W

Monument (s) Set (Procedures and Description)

A 1 1/4"x30" galvanized iron pipe with a 2 1/2" brass cap, 22" below surface .Stamped as shown above. Set by single proportionate method.

References Set: "Deep One" magnets by Bermtsen.

- An Orange Magnet 22" deep, lies N 34°27'07" W, 18.68'.
- A Silver Magnet 21" deep, lies N 34°13'15" E, 18.87'.
- A Pink Magnet 22" deep, lies S 44°43'46" E, 23.87'.
- A Blue Magnet 22" deep, lies S 37°14'17" W, 20.87'.

Location and Comments

The corner is .5 miles West of the intersection of Hwy 320 and Snow Road, approx. 600' W. of center pivot. Follow road to pivot.

Compass Declination
17° E

Surveyors Seal

REGISTERED
PROFESSIONAL
LAND SURVEYOR

Robert D. English
OREGON
JANUARY 11, 2005
ROBERT DOUGLAS ENGLISH
43406LS

RECEIVED BY:

Firm / Agency

Survey One, LLC.
P.O. Box 382
Pendleton, OR 97801
(541) 276-2055

Date: 1-11
Rec'd By: RR
No. 11-15-R

RENEWAL DATE: 12/31/11