

OREGON CORNER RESTORATION FORM

Section 17,18,19,20
County Umatilla

Township 3N
Date: 3/8/10

Range 29E

Corner Designation: 3N29N5

Corner common to Sections 17,18,19,20 T3NR29E.

- Condition Report Only
- Not Found
- Remonumented
- Unrecorded
- Surveyed In
- Referenced Out


Previous Renewals / Surveys, etc.

Originally Surveyed by Gates in 1859. He set a post in a mound of earth. Staebler set Brass Cap at this location in Survey I-158-B.


Monuments and Accessories Found: (Condition and Source)

None. This area has been heavily excavated and graded with the installation of a Center Pivot.

Diagram

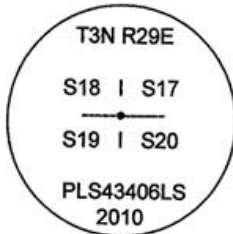

Sketch

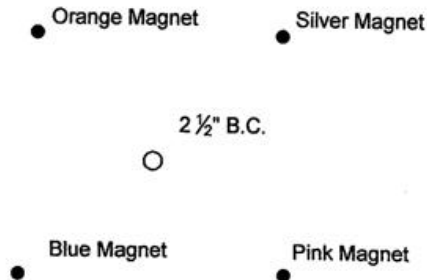

NAD 83/91
OREGON STATE PLANE NORTH
INTERNATIONAL FEET

N756104.63
E8527467.63

LAT - 45° 44' 00.72370483" N
LON - 119° 13' 32.62285113" W

Monument (s) Set (Procedures and Description)

Set a 1" id x 30" Galvanized Iron Pipe with a 2 1/2" Brass cap, buried 23" below surface, stamped as shown above. Reset from ties to Staebler's survey monuments. Note: there is a typo on Don's survey plat. The called distance to the middle of the highway, from the 1/4 corner does not check with the overall distance calls, but the call back from the corner to the highway fits perfectly.

References Set: "Deep One" magnets by Berntsen.

- A Silver magnet, 20" deep, lies N 43°40' E, 21.94'.
- A Pink magnet, 20" deep, lies S 20°40' E, 23.78'.
- A Blue magnet, 19" deep, lies S 50° W, 26.31'.
- An Orange magnet, 20" deep, lies N 32° W, 22.70'.

Location and Comments

From the intersection of Hwy. 320 and Snow Road, go 0.5 miles West, the corner is North of the House.

Compass Declination
17° E

Surveyors Seal

REGISTERED
PROFESSIONAL
LAND SURVEYOR

Robert D. English

OREGON
JANUARY 11, 2005
ROBERT DOUGLAS ENGLISH
43406LS

RENEWAL DATE: 12/31/11

RECEIVED BY:

Date: 3-10

Rec'd By: KK

No. 10-30-R

Firm / Agency

Survey One, LLC.
P.O. Box 382
Pendleton, OR 97801
(541) 276-2055