

OREGON CORNER RESTORATION FORM

Section 19 Township 3N Range 29E
County Umatilla Date: 09/21/09

Corner Designation: 3N29P1

1/4 Corner common to sections 19, T3NR29E, and 24, T3NR28E.

- Condition Report Only
- Not Found
- Remonumented
- Unrecorded
- Surveyed In
- Referenced Out


Previous Renewals / Surveys, etc.

Originally Surveyed by N.H. Gates in 1859. He set a post in a mound of earth.


Monuments and Accessories Found: (Condition and Source)

None.

Diagram

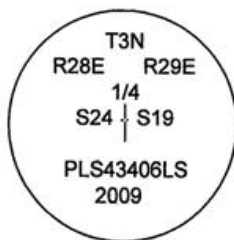

Sketch

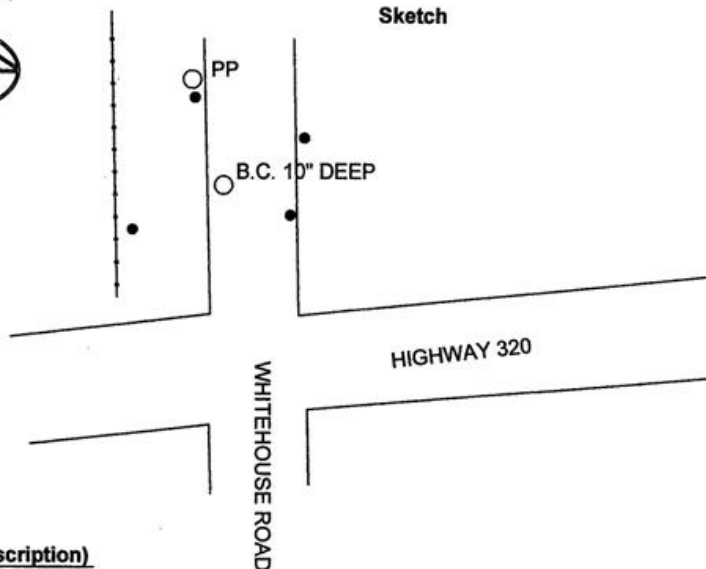

NAD 83/91
OREGON STATE PLANE NORTH
INTERNATIONAL FEET

N753172.04
E8521702.97

LAT - 45° 43' 32.66755" N
LON - 119° 14' 54.52604" W

Monument (s) Set (Procedures and Description)

Set a 1 1/8" x 30" galvanized iron pipe with a 2 1/2" Brass cap stamped as shown below, by single proportionate measure.

References Set:

- A 3/8" x 30" Iron rebar w/rpc #43406 lies S 70°00' E, 18.77'.
- A 3/8" x 30" Iron rebar w/rpc #43406 lies S 66°00' W, 47.90'.
- A 3/8" x 30" Iron rebar w/rpc #43406 lies N 45°45' E, 29.98'.
- A 3/8" x 30" Iron rebar w/rpc #43406 lies N 9°30' W, 71.73'.

Location and Comments

The corner is approximately 100' North of the intersection of Hwy. 320 and Whitehouse Road.

Compass Declination

17° E

Surveyors Seal

REGISTERED
PROFESSIONAL
LAND SURVEYOR

Robert D. English

OREGON
JANUARY 11, 2005
ROBERT DOUGLAS ENGLISH
43406LS

RECEIVED BY:

Date: 10-09
 Rec'd By: KE
 No. 09-146-E

Firm / Agency

Survey One, LLC.
 P.O. Box 382
 Pendleton, OR 97801
 (541) 276-2055

RENEWAL DATE: 12/31/09