

OREGON CORNER RESTORATION FORM

Section 23

Township 3N

Range 29E

County Umatilla

Date: 05/05/09

Corner Designation: 3N29P21

Corner common to sections 23,24, T3NR29E

- Condition Report Only
- Not Found
- Remonumented
- Unrecorded
- Surveyed In
- Referenced Out


Previous Renewals / Surveys, etc.

Originally Surveyed by N.H. Gates. He set a post in a mound of earth in 1859.
W.R. Wells set a 2 1/2" BC in the ground and surrounded with a mound of earth.


Monuments and Accessories Found: (Condition and Source)

- A 2 1/2" Brass cap, in good condition.
- A 5/8" Iron rebar w/ypc PLS1106 lies North, 46.05".
- A 5/8" Iron rebar w/ypc PLS1106 lies S 00°08'13" E, 792.00'.
- A brass washer on a rr tie fence post PLS1106 lies S 00°30' E, 28.60'.

Diagram

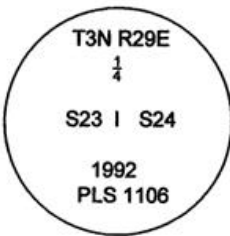

Sketch

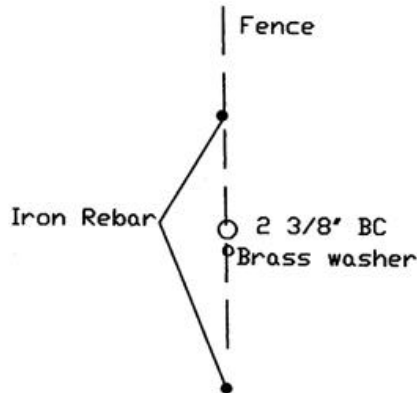

NAD 83/91
OREGON STATE PLANE NORTH
INTERNATIONAL FEET

N753817.35
E8548794.23
LAT - 45° 43' 34.7239" N
LON - 119° 08' 32.5419" W

Monument (s) Set (Procedures and Description)

None

References Set:

None

Location and Comments

The corner is 1.5 miles south of
Coppinger Lane and Highway 320,
and West 1 mile across the field.

Compass Declination
17° E

Surveyors Seal

REGISTERED
PROFESSIONAL
LAND SURVEYOR

Robert D. English
OREGON
JANUARY 11, 2005
ROBERT DOUGLAS ENGLISH
43406LS

RENEWAL DATE: 12/31/09

RECEIVED BY:

Date: 5-07
Rec'd By: RE
No. 09-78-R

Firm / Agency

Survey One, LLC.
P.O. Box 382
Pendleton, OR 97801
(541) 276-2055