

OREGON CORNER RESTORATION FORM

Section 20 Township 3N
County Umatilla Date: 08/31/09

Range 29E

Corner Designation: 3N29P5

1/4 Corner common to sections 19 and 20, T3NR29E.

- Condition Report Only
- Not Found
- Remonumented
- Unrecorded
- Surveyed In
- Referenced Out


Previous Renewals / Surveys, etc.

Originally Surveyed by N.H. Gates in 1859. He set a post in a mound of earth.
Staebler set a Brass Cap on survey I-158-B.
Edwards found a Brass Cap on survey 91-73-C.


Monuments and Accessories Found: (Condition and Source)

Found A 2.5" B.C.

Diagram

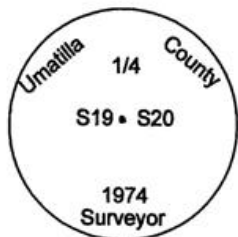

Sketch

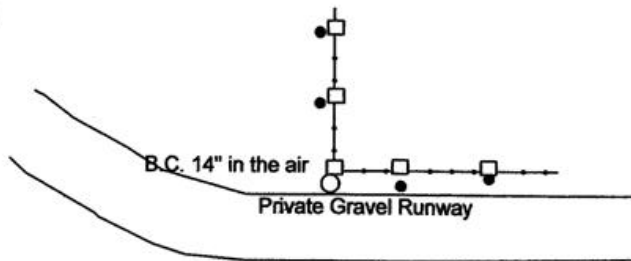

NAD 83/91
OREGON STATE PLANE NORTH
INTERNATIONAL FEET

N753421.58
E8527531.93

LAT - 45° 43' 34.23147" N
LON - 119° 13' 32.3129" W

Monument (s) Set (Procedures and Description)

None.

References Set:

- A 3/8" x 30" Iron rebar w/ypc #43406 lies S 1°30' E, 27.31'.
- A 3/8" x 30" Iron rebar w/ypc #43406 lies S 0°30' E, 11.27'.
- A 3/8" x 30" Iron rebar w/ypc #43406 lies N 0°30' W, 11.08'.
- A 3/8" x 30" Iron rebar w/ypc #43406 lies S 88°00' W, 25.77'.

Location and Comments

The corner is .7 miles south of the intersection of Hwy 320 and Echo Meadows Road, then right .5 miles down a private gravel road.

Compass Declination
17° E

Surveyors Seal

REGISTERED
PROFESSIONAL
LAND SURVEYOR

Robert D. English
OREGON
JANUARY 11, 2005
ROBERT DOUGLAS ENGLISH
43406LS

RECEIVED BY:

Date: 10-09
Rec'd By: KE
No. 09-146R

Firm / Agency

Survey One, LLC.
P.O. Box 382
Pendleton, OR 97801
(541) 276-2055

RENEWAL DATE: 12/31/09