

OREGON CORNER RESTORATION FORM

Section 22,23,26,27

Township 3N

Range 29E

County Umatilla

Date: 8/12/10

Corner Designation: 3N29R17

Section corner common to T3NR29E sections 22,23,26, and 27.

- Condition Report Only
- Not Found
- Remonumented
- Unrecorded
- Surveyed In
- Referenced Out



Previous Renewals / Surveys, etc.

Originally Surveyed by Gates in 1859. He set a post in a mound of earth.

Monuments and Accessories Found: (Condition and Source)

None.

Diagram

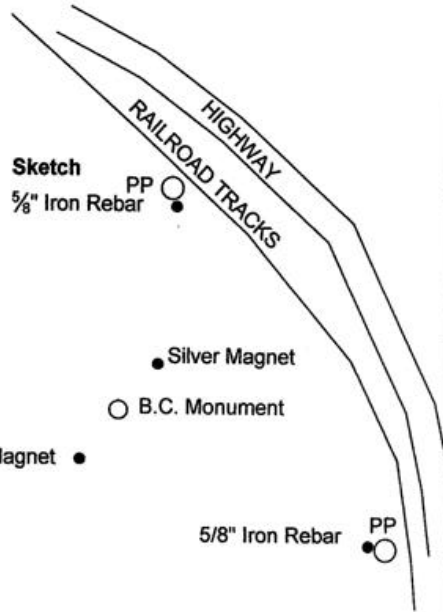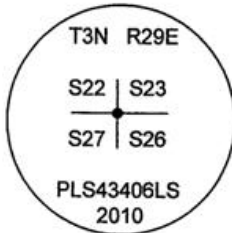

NAD 83/91
OREGON STATE PLANE NORTH
INTERNATIONAL FEET

N751080.97
E8543520.87

LAT - 45° 43' 08.57953" N
LON - 119° 09' 47.50661" W

Monument (s) Set (Procedures and Description)

1 1/4" x 30" galvanized iron pipe w/ a 2 1/2" brass cap, 20" below the surface, stamped as shown above. Corner re-established by Double Proportionate Method with weight given to existing fences.

References Set: "Deep One" magnets by Berntsen.

A 5/8" x 30" Iron rebar w/rpc #43406LS lies N 39°40' W, 168.79'.

A Silver magnet 20" deep lies N 11° E, 13.11'.

A 5/8" x 30" Iron rebar w/rpc #43406LS lies S 64°30' E, 167.41'.

A Blue magnet 19" deep lies S 7° E, 20.63'.

Location and Comments

Corner is located in the edge of an existing alfalfa field just N & W of Ramos residence.

Compass Declination

17° E

Surveyors Seal

REGISTERED
PROFESSIONAL
LAND SURVEYOR

Robert D. English
OREGON
JANUARY 11, 2005
ROBERT DOUGLAS ENGLISH
43406LS

RENEWAL DATE: 12/31/11

RECEIVED BY:

Date: 1-11
Rec'd By: KK
No. 11-17-R

Firm / Agency

Survey One, LLC.
P.O. Box 382
Pendleton, OR 97801
(541) 276-2055