

**OREGON CORNER RESTORATION FORM**

Section 24,25 Township 3N  
County Umatilla Date: 04/27/10

Range 29E

Corner Designation: 3N29R23

Corner common to sections 24,25 T3NR29E.

_____	Condition Report Only
<u>  X  </u>	Not Found
<u>  X  </u>	Remonumented
_____	Unrecorded
<u>  X  </u>	Surveyed In
<u>  X  </u>	Referenced Out


**Previous Renewals / Surveys, etc.**

Originally Surveyed by Gates in 1859. He set a post in a mound of earth.


**Monuments and Accessories Found: (Condition and Source)**

None.

**Diagram**

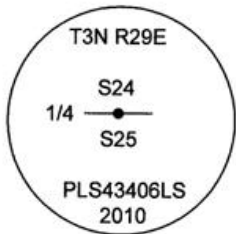

**Sketch**

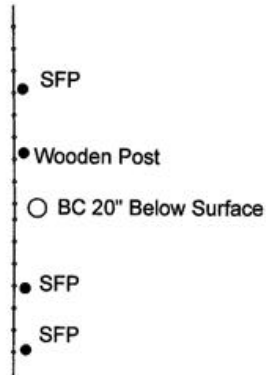

NAD 83/91  
OREGON STATE PLANE NORTH  
INTERNATIONAL FEET

N751231.47  
E8551453.49  
LAT - 45° 43' 08.74943" N  
LON - 119° 07' 55.67088" W

**Monument (s) Set (Procedures and Description)**

A 1 1/2" x 30" Galvanized iron pipe with a 2 1/2" Brass cap, stamped as shown above. This corner was reset by single proportionate methods, which fit an existing ancient North-South fence very well, and apparent lines of occupation.

**References Set:**

- A 5/8" x 30" Iron rebar w/rpc #43406 lies N 11°20' E, 11.15'
- A 5/8" x 30" Iron rebar w/rpc #43406 lies S 4°30' W, 34.37'.
- A 5/8" x 30" Iron rebar w/rpc #43406 lies S 11° W, 12.90'.
- A 5/8" x 30" Iron rebar w/rpc #43406 lies N 2° W, 54.61'.

**Location and Comments**

The corner is 2.0 miles south of the intersection of Coppinger Lane and Highway 320, and 0.5 miles West.

**Compass Declination**

17° E

**Surveyors Seal**

REGISTERED  
PROFESSIONAL  
LAND SURVEYOR

*Robert Douglas English*  
 OREGON  
 JANUARY 11, 2005  
 ROBERT DOUGLAS ENGLISH  
 43406LS

RENEWAL DATE: 12/31/11

**RECEIVED BY:**

Date: 5-10  
 Rec'd By: KR  
 No. 10-84-R

**Firm / Agency**

Survey One, LLC.  
 P.O. Box 382  
 Pendleton, OR 97801  
 (541) 276-2055