

OREGON CORNER RESTORATION FORM

Section 30

Township 3N

Range 29E

County Umatilla

Date: 09/25/09

Corner Designation: 3N29T1

1/4 corner common to sections 30, T3NR29E, 25, T3NR28E.

_____	Condition Report Only
_____X_____	Not Found
_____X_____	Remonumented
_____	Unrecorded
_____X_____	Surveyed In
_____X_____	Referenced Out

Previous Renewals / Surveys, etc.

Originally Surveyed by Gates in 1859. He set a post in a mound of earth.


Monuments and Accessories Found: (Condition and Source)

None.

Diagram



Sketch

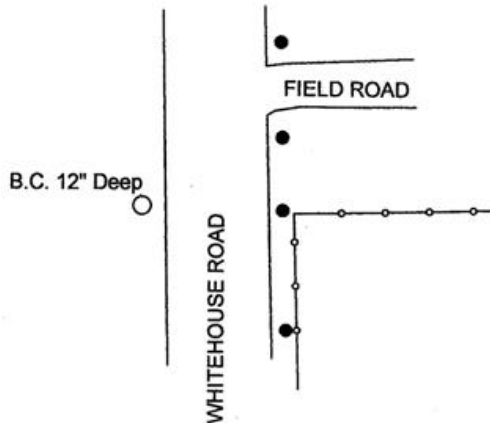

NAD 83/91
OREGON STATE PLANE NORTH
INTERNATIONAL FEET

N747840.04
E8521793.81

LAT - 45° 42' 40.02187" N
LON - 119° 14' 54.41683" W

Monument (s) Set (Procedures and Description)

Set a 2 1/2" Brass cap on a 1 1/4" x 30" galvanized iron pipe 13 inches below the surface by single proportionate measure.

References Set:

- A 1/2" Iron rebar w/ypc #43406 lies N 65°15' E, 42.63'.
- A 1/2" Iron rebar w/ypc #43406 lies N 26°00' E, 106.15'.
- A 1/2" Iron rebar w/ypc #43406 lies S 86°30' E, 35.53'.
- A 1/2" Iron rebar w/ypc #43406 lies S 55°45' E, 40.83'.

Location and Comments

From the intersection of Whitehouse Road and Hwy. 320, go 1 mile South to the point.

Compass Declination

17° E

Surveyors Seal

REGISTERED
PROFESSIONAL
LAND SURVEYOR

Robert Douglas English
 OREGON
 JANUARY 11, 2005
 ROBERT DOUGLAS ENGLISH
 43406LS

RENEWAL DATE: 12/31/09

RECEIVED BY:

Date: 1-11
 Rec'd By: KK
 No. 11-18-R

Firm / Agency

Survey One, LLC.
 P.O. Box 382
 Pendleton, OR 97801
 (541) 276-2055