

**OREGON CORNER RESTORATION FORM**

Section 28,27 Township 3N  
County Umatilla Date: 08/09/10

Range 29E

Corner Designation: 3N29T13

Corner common to sections 27,28 T3NR29E.

- Condition Report Only
- Not Found
- Remonumented
- Unrecorded
- Surveyed In
- Referenced Out


**Previous Renewals / Surveys, etc.**

Originally Surveyed by Gates. He set a post in a mound of earth in 1859.


**Monuments and Accessories Found: (Condition and Source)**

None.

**Diagram**

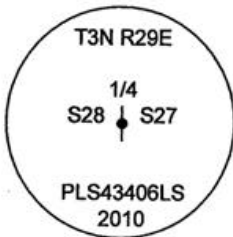

**Sketch**

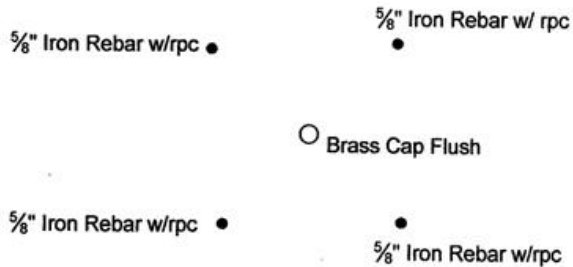

NAD 83/91  
OREGON STATE PLANE NORTH  
INTERNATIONAL FEET

N748297.46  
E8538248.69

LAT - 45° 42' 41.95607" N  
LON - 119° 11' 02.44625" W

**Monument (s) Set (Procedures and Description)**

A 1 1/2" x 30" galvanized iron pipe w/ a 2 1/2" brass cap, flush with the surface, stamped as shown above. SFP guard post S of mon. Set by single proportionate method.

**References Set:**

- A 5/8" Iron rebar w/rpc #43406 flush, lies N 49°45' W, 16.19'.
- A 5/8" Iron rebar w/rpc #43406 flush, lies N 45°20' E, 14.35'.
- A 5/8" Iron rebar w/rpc #43406 flush, lies S 40°30' E, 14.55'.
- A 5/8" Iron rebar w/rpc #43406 flush, lies S 44°40' W, 17.32'.

**Location and Comments**

Corner is on a barren ridge S of Piercy's Vineyard.

**Compass Declination**

17° E

**Surveyors Seal**

REGISTERED  
PROFESSIONAL  
LAND SURVEYOR

*Robert Douglas English*  
 OREGON  
 JANUARY 11, 2005  
 ROBERT DOUGLAS ENGLISH  
 43406LS

RENEWAL DATE: 12/31/11

**RECEIVED BY:**

Date: 1-11  
 Rec'd By: KK  
 No. 11-18-R

**Firm / Agency**

Survey One, LLC.  
 P.O. Box 382  
 Pendleton, OR 97801  
 (541) 276-2055