

OREGON CORNER RESTORATION FORM

Section 27,26 Township 3N
County Umatilla Date: 08/18/10

Range 29E

Corner Designation: 3N29T17

Corner common to sections 26,27 T3NR29E.

- Condition Report Only
- Not Found
- Remonumented
- Unrecorded
- Surveyed In
- Referenced Out


Previous Renewals / Surveys, etc.

Originally Surveyed by Gates. He set a post in a mound of earth in 1859.


Monuments and Accessories Found: (Condition and Source)

None.

Diagram

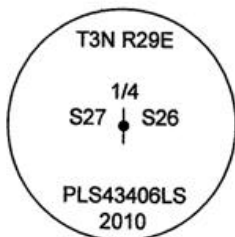

Sketch

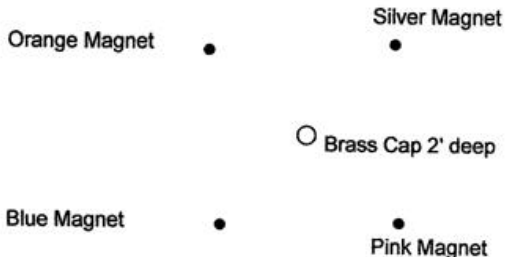

NAD 83/91
OREGON STATE PLANE NORTH
INTERNATIONAL FEET

N748431.26
E8543576.55

LAT - 45° 42' 42.41331" N
LON - 119° 09' 47.33990" W

Monument (s) Set (Procedures and Description)

A 1 1/2" x 30" galvanized iron pipe w/ a 2 1/2" brass cap, 24" below the surface, stamped as shown above. Set by single proportionate method.

References Set: "Deep One" magnets by Berntsen.

- An Orange magnet 19" deep, lies N 55°45' W, 21.58'.
- A Silver magnet 21" deep, lies N 31°00' E, 18.49'.
- A Pink magnet 18" deep, lies S 43°00' E, 18.08'.
- A Blue magnet 14" deep, lies S 36°45' W, 18.60'.

Location and Comments

Corner is in an alfalfa field approx.
S45°W of Ramos residence on the
old Rieth - Echo Highway.

Compass Declination

17° E

Surveyors Seal

REGISTERED
PROFESSIONAL
LAND SURVEYOR

Robert D. English
OREGON
JANUARY 11, 2005
ROBERT DOUGLAS ENGLISH
43406LS

RECEIVED BY:

Date: 1-11
Rec'd By: *KK*
No. 11-DIP-R

Firm / Agency

Survey One, LLC.
P.O. Box 382
Pendleton, OR 97801
(541) 276-2055

RENEWAL DATE: 12/31/11