

OREGON CORNER RESTORATION FORM

Section 28,29
County Umatilla

Township 3N
Date: 03/08/10

Range 29E

Corner Designation: 3N29T9

1/4 Corner common to sections 28,29 T3NR29E

_____	Condition Report Only
<u> X </u>	Not Found
_____	Remonumented
_____	Unrecorded
<u> X </u>	Surveyed In
<u> X </u>	Referenced Out

Previous Renewals / Surveys, etc.

Originally Surveyed by Gates, set a post in a mound of earth, 1859.


Monuments and Accessories Found: (Condition and Source)

None.

Diagram



Sketch

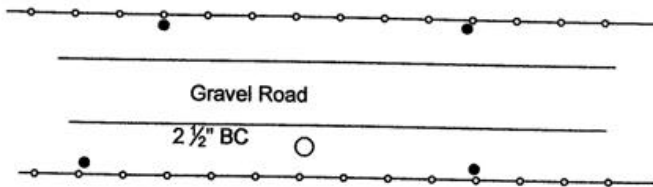

Rock Pit

NAD 83/91
OREGON STATE PLANE NORTH
INTERNATIONAL FEET

N748174.12
E8532961.36

LAT - 45° 42' 41.57718239" N
LON - 119° 12' 16.97204099" W

Monument (s) Set (Procedures and Description)

Set a 1 1/8" x 30" galvanized Iron pipe with a 2 1/2" Brass cap, stamped as shown above.
Corner set by single proportionate method from ties to corners North and South 1/2 mile.

References Set:

- A 5/8"x30" Iron rebar w/rpc #43406 lies N 36°40' W, 62.89'.
- A 5/8"x30" Iron rebar w/rpc #43406 lies N 19°40' E, 56.04'.
- A 5/8"x30" Iron rebar w/rpc #43406 lies S 69°20' E, 19.08'.
- A 5/8"x30" Iron rebar w/rpc #43406 lies S 76°40' W, 30.81'.

Location and Comments

The corner is 1.7 miles South of the intersection of Hwy. 320 and Snow Road, then East on a gravel road 0.5 miles to the point. This point is North of a gravel pit, in a significant road cut.

Compass Declination
17° E

Surveyors Seal

REGISTERED
PROFESSIONAL
LAND SURVEYOR

Robert D. English
 OREGON
 JANUARY 11, 2005
 ROBERT DOUGLAS ENGLISH
 43406LS

RENEWAL DATE: 12/31/11

RECEIVED BY:

Date: 3-10
 Rec'd By: KE
 No. 10,411-R

Firm / Agency

Survey One, LLC.
 P.O. Box 382
 Pendleton, OR 97801
 (541) 276-2055