

OREGON CORNER RESTORATION FORM

Section 27,34 Township 3N
County Umatilla Date: 05/27/10

Range 29E

Corner Designation: 3N29V15

Corner common to section 27 and 34 T3NR29E.


- Condition Report Only
- Not Found
- Remonumented
- Unrecorded
- Surveyed In
- Referenced Out

Previous Renewals / Surveys, etc.

Originally Surveyed by Gates in 1859. He set a post in a mound of earth.

Monuments and Accessories Found: (Condition and Source)

None.

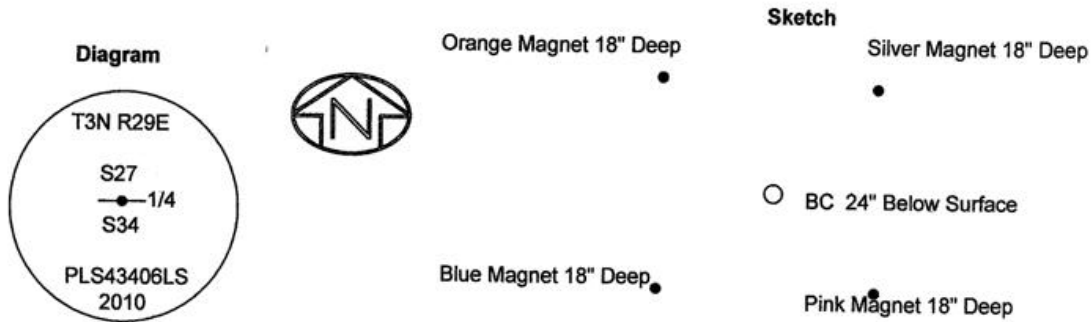

NAD 83/91
OREGON STATE PLANE NORTH
INTERNATIONAL FEET

N745708.98
E8540973.29

LAT - 45° 42' 15.96336" N
LON - 119° 10' 24.65258" W

Monument (s) Set (Procedures and Description)

A 1 1/2" x 30" galvanized iron pipe with a 2 1/2" brass cap, stamped as shown above. Set by single proportionate method. Falls on an open hillside.

References Set: "Deep One" magnets by Berntsen.
An Orange magnet, 18" deep lies N 43°30' W, 12.96'.
A Silver magnet, 18" deep lies N 44°30' E, 14.07'.
A Pink magnet, 18" deep lies S 42°30' E, 15.15'.
A Blue magnet, 18" deep lies S 44°30' W, 13.30'.

Location and Comments

This corner is in Dry Land CRP/Crop Rotation, and is accessible from the South edge of Lloyd Piercy's Vineyard road.

Compass Declination
17° E

Surveyors Seal

REGISTERED
PROFESSIONAL
LAND SURVEYOR

Robert D. English
OREGON
JANUARY 11, 2005
ROBERT DOUGLAS ENGLISH
43406LS

RECEIVED BY:

Date: 1-11
Rec'd By: KR
No. 11-19-R

Firm / Agency

Survey One, LLC.
P.O. Box 382
Pendleton, OR 97801
(541) 276-2055

RENEWAL DATE: 12/31/11