

OREGON CORNER RESTORATION FORM

Section 26,27,34,35

Township 3N

Range 29E

County Umatilla

Date: 8/06/10

Corner Designation: 3N29V17

Section corner common to T3NR29E sections 26,27,34, and 35.

- Condition Report Only
- Not Found
- Remonumented
- Unrecorded
- Surveyed In
- Referenced Out


Previous Renewals / Surveys, etc.

Originally Surveyed by Gates in 1859. He set a post in a mound of earth.


Monuments and Accessories Found: (Condition and Source)

None.

Diagram

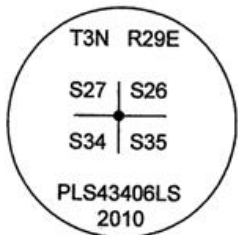

Sketch

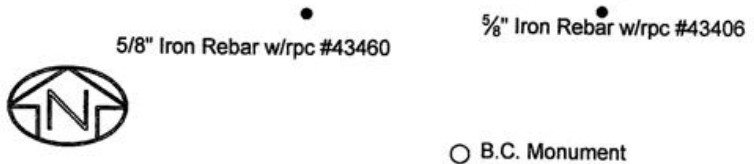

NAD 83/91
OREGON STATE PLANE NORTH
INTERNATIONAL FEET

5/8" Iron Rebar w/rpc #43406

5/8" Iron Rebar w/rpc #43406

N745786.41
E8543626.89

LAT - 45° 42' 16.291075" N
LON - 119° 09' 47.24043" W

Monument (s) Set (Procedures and Description)

1 1/4" x 30" galvanized iron pipe w/ a 2 1/2" Brass cap, 20" deep, stamped as shown above. Corner was re-established by double proportionate measurement.

References Set:

- A 5/8" x 30" Iron rebar w/rpc #43406LS lies N 19°12' W, 14.28'.
- A 5/8" x 30" Iron rebar w/rpc #43406LS lies N 65°10' E, 15.62'.
- A 5/8" x 30" Iron rebar w/rpc #43406LS lies S 15°30' E, 15.05'.
- A 5/8" x 30" Iron rebar w/rpc #43406LS lies S 50°50' W, 15.62'.

Location and Comments

Corner is on a NWly slope above a small, steep draw that runs into the Umatilla River. Barren Hillside.

Compass Declination

17° E

Surveyors Seal

REGISTERED
PROFESSIONAL
LAND SURVEYOR

Robert D. English
OREGON
JANUARY II, 2005
ROBERT DOUGLAS ENGLISH
43406LS

RECEIVED BY:

Firm / Agency

Survey One, LLC.
P.O. Box 382
Pendleton, OR 97801
(541) 276-2055

Date: 8-10
Rec'd By: KE
No. 10-148-R

RENEWAL DATE: 12/31/11