

OREGON CORNER RESTORATION FORM

Section 36 Township 3N
County Umatilla Date: 05/05/09

Range 29E

Corner Designation: 3N29V23

Corner common to sections 25,36, T3NR29E.


- _____ Condition Report Only
- _____ Not Found
- _____ X _____ Remonumented
- _____ Unrecorded
- _____ Surveyed In
- _____ Referenced Out

Previous Renewals / Surveys, etc.


Originally Surveyed by Gates in 1859. He set a post in a mound of earth.

Monuments and Accessories Found: (Condition and Source)

Diagram

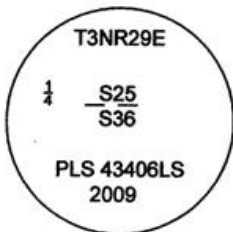

Sketch

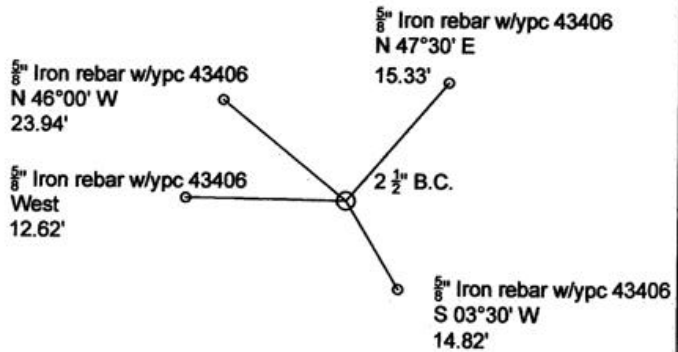

NAD 83/91
OREGON STATE PLANE NORTH
INTERNATIONAL FEET

N745961.096
E8551557.701

LAT - 45° 42' 16.70967" N
LON - 119° 07' 55.46685" W

Monument (s) Set (Procedures and Description)

Set A 1"x30" flared galvanized iron pipe with a 2 1/2" B.C. by best evidence at a 3-way fence intersection, south, east, west.

References Set:

- A 5/8" x 30" Iron rebar w/ypc #43406 lies S 03°30' W, 14.82'
- A 5/8" x 30" Iron rebar w/ypc #43406 lies West, 12.62'.
- A 5/8" x 30" Iron rebar w/ypc #43406 lies N 46°00' W, 23.94'.
- A 5/8" x 30" Iron rebar w/ypc #43406 lies N 47°30' E, 15.33'.

Location and Comments

The corner is 3 miles south of the intersection of Coppinger Lane and Highway 320, then go .5 miles West along fenceline.

Compass Declination
17° E

Surveyors Seal

REGISTERED
PROFESSIONAL
LAND SURVEYOR

Robert D. English
OREGON
JANUARY 11, 2005
ROBERT DOUGLAS ENGLISH
43406LS

RECEIVED BY:

Date: 5-09
Rec'd By: KE
No. 09-29-R

Firm / Agency

Survey One, LLC.
P.O. Box 382
Pendleton, OR 97801
(541) 276-2055

RENEWAL DATE: 12/31/09