

**OREGON CORNER RESTORATION FORM**

Section 36 Township 3N  
County Umatilla Date: 05/05/09

Range 29E

Corner Designation: 3N29X25

1/4 corner common to sections 36, T3NR29E, 31, T3NR30E.


- \_\_\_\_\_ Condition Report Only
- \_\_\_\_\_ Not Found
- \_\_\_\_\_ X \_\_\_\_\_ Remonumented
- \_\_\_\_\_ Unrecorded
- \_\_\_\_\_ Surveyed In
- \_\_\_\_\_ Referenced Out

**Previous Renewals / Surveys, etc.**


Originally Surveyed by David P. Thompson in 1859. He set a post in a mound of earth.

**Monuments and Accessories Found: (Condition and Source)**

Diagram

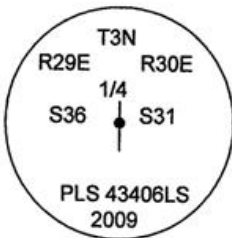

Sketch

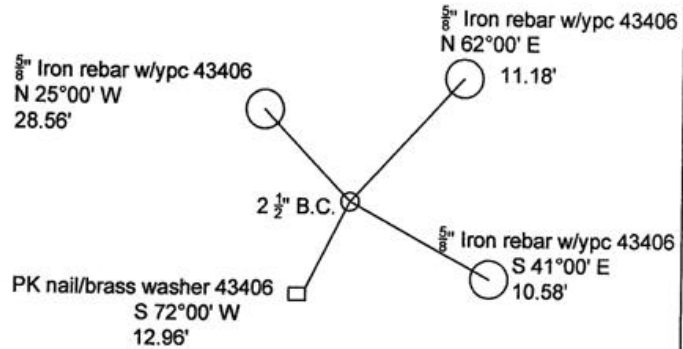

NAD 83/91  
OREGON STATE PLANE NORTH  
INTERNATIONAL FEET

N743340.32  
E8554233.28

LAT - 45° 41' 50.38935" N  
LON - 119° 07' 18.40008" W

**Monument (s) Set (Procedures and Description)**

Set a 1 1/4" x 30" galvanized iron pipe with a 2 1/2" brass cap, 15" below surface, by single proportion method, from SE Township corner and old fence corner at the NE corner of section 36.

**References Set:**

- A 5/8" x 30" Iron rebar w/ypc #43406 12" deep lies N 62°00' E, 11.18'
- A 5/8" x 30" Iron rebar w/ypc #43406 12" deep lies S 41°00' E, 10.58'
- A PK nail and Brass washer #43406 on a railroad tie fence post lies S 72°00' W, 12.96'.
- A 5/8" x 30" Iron rebar w/ypc #43406 and tee post lies N 25°00' W, 28.56'.

**Location and Comments**

The corner is in the north edge of the Oregon Trail and is 1/2 mile north of the Umatilla River.

**Compass Declination**  
17° E

**Surveyors Seal**

REGISTERED  
PROFESSIONAL  
LAND SURVEYOR

*Robert D. English*  
OREGON  
JANUARY 11, 2005  
ROBERT DOUGLAS ENGLISH  
43406LS

**RECEIVED BY:**

Date: 1-11  
Rec'd By: KE  
No. 11-20-R

**Firm / Agency**

Survey One, LLC.  
P.O. Box 382  
Pendleton, OR 97801  
(541) 276-2055

RENEWAL DATE: 12/31/09