

OREGON CORNER RESTORATION FORM

Section 35 Township 3N
County Umatilla Date: 03/08/10

Range 29E

Corner Designation: 3N29Z19

Corner common to sections 35 T3NR29E, 2 T2NR29E.

- Condition Report Only
- Not Found
- Remonumented
- Unrecorded
- Surveyed In
- Referenced Out


Previous Renewals / Surveys, etc.

Originally Surveyed by David P. Thompson. He set a post in a mound of earth in 1859.


Monuments and Accessories Found: (Condition and Source)

None.

Diagram

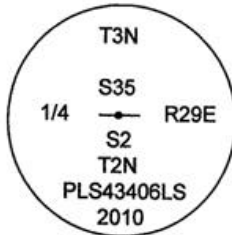

Sketch

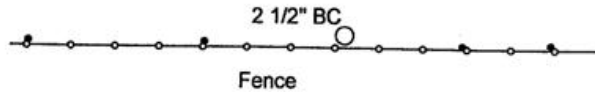

NAD 83/91
OREGON STATE PLANE NORTH
INTERNATIONAL FEET

N740547.15
E8546331.8

LAT - 45° 41' 24.12693458" N
LON - 119° 09' 10.36128762" W

Monument (s) Set (Procedures and Description)

Set 2 1/2" Brass Cap on 1"X30" galvanized iron pipe flush with ground, by single proportionate method, marked as shown above.

References Set:

- A 5/8"x30" Iron rebar w/ypc #43406 lies East, 50.82'.
- A 5/8"x30" Iron rebar w/ypc #43406 lies S 89° E, 16.41'.
- A 5/8"x30" Iron rebar w/ypc #43406 lies S 88°30' W, 13.80'.
- A 5/8"x30" Iron rebar w/ypc #43406 lies S 89°15' W, 28.34'.

Location and Comments

The corner is 3.0 miles East of the cattle guard at the South end of Snow Road along the East-West fence.

Compass Declination

17° E

Surveyors Seal

REGISTERED
PROFESSIONAL
LAND SURVEYOR

Robert D. English
 OREGON
 JANUARY 11, 2005
 ROBERT DOUGLAS ENGLISH
 43406LS

RENEWAL DATE: 12/31/11

RECEIVED BY:

Date: 3-10
 Rec'd By: RR
 No. 1051-R

Firm / Agency

Survey One, LLC.
 P.O. Box 382
 Pendleton, OR 97801
 (541) 276-2055