

**OREGON CORNER RESTORATION FORM**

SECTION: 5 TOWNSHIP: 2N RANGE: 29E A-5

COUNTY: UMATILLA DATE 8/2010

**CORNER DESIGNATION**

NW 5

- CONDITION REPORT ONLY
- NOT FOUND
- RENEWED
- UNRECORDED
- SURVEYED IN
- REFERENCED OUT

**PREVIOUS RENEWALS/SURVEYS ETC.**


Originally surveyed by Thompson under Contract #83 in 1859. He set post and made mound. In 1964 Wayne Harris Set a 5/8" iron rebar and stone in a survey for Cunha-Correa.

**MONUMENTS AND ACCESSORIES FOUND: CONDITON AND SOURCE**

Found bent 5/8" iron rebar 6" below the surface of a cultivated field.

**MONUMENT DETAIL**

T3N R29E  
31 | 32  
6 | 5  
T2N  
2008  
LS 951

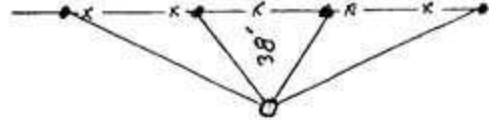

**OREGON STATE PLANE COORDINATES NORTH ZONE, NAD 83(91), Int Feet:**

740003.31  
8527775.24

**MONUMENT SET (PROCEDURES AND DESCRIPTION)**

In place of bent 5/8" iron rebar I set a 2 3/8" brass cap on a 1" by 15" iron pipe 20" below the surface. Laid rebar next to W.C.

**NEW ACCESSORIES FROM WHICH**

- A 5/8" x 30" Iron Rebar with plastic cap #951 bears N 64° 16' 42" W 82.60'
  - A 5/8" x 30" Iron Rebar with plastic cap #951 bears N 31° 07' 38" W 44.33'
  - A 5/8" x 30" Iron Rebar with plastic cap #951 bears N 9° 56' 29" E 41.25'
  - A 5/8" x 30" Iron Rebar with plastic cap #951 bears N 68° 59' 47" E 114.57'
- These bearings and distances are State Plane.

**LOCATION AND COMMENTS**

From the intersection of the Heppner to Echo Highway with Snow Road go South on Snow Road 3.1 miles to a fence line. Go West along fence line 0.5 mile to corner (38' south of fence line).

FIRM: EDWARDS SURVEYING LLC  
PO BOX 763 - HERMISTON OR 97838

PARTY CHIEF: G. EDWARDS  
WITNESS: R. SMITH

SURVEYOR'S SEAL

