

OREGON CORNER RESTORATION FORM

Section 32 Township 3N
County Umatilla Date: 01/21/10

Range 29E

Corner Designation: 3N29Z7

Corner common to sections 32, T3NR29E, 5 T2NR29E.

- Condition Report Only
- Not Found
- Remonumented
- Unrecorded
- Surveyed In
- Referenced Out


Previous Renewals / Surveys, etc.

Originally Surveyed by David P. Thompson. He set a post in a mound of earth in 1859.
LCR 02-184-B


Monuments and Accessories Found: (Condition and Source)

A 2"x36" Galvanized Iron pipe with a 2 1/8" Bureau of Reclamation Brass cap, bent to the north. Straightened the pipe and reburied. Re-stamped the cap as shown below.

Diagram

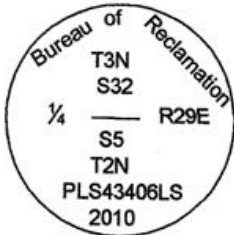

Sketch

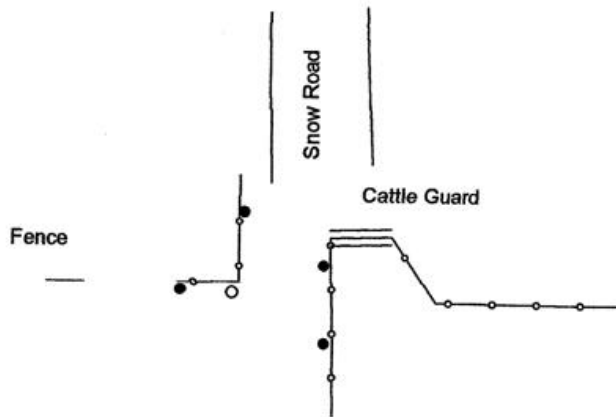

NAD 83/91
OREGON STATE PLANE NORTH
INTERNATIONAL FEET

N740098.02
E8530403.64
LAT - 45° 41' 22.25943" N
LON - 119° 12' 54.83005" W

Monument (s) Set (Procedures and Description)

- A 5/8"x30" Iron rebar w/ypc #43406 lies N 9°30' E, 23.59'.
- A 5/8"x30" Iron rebar w/ypc #43406 lies N 59° E, 33.12'.
- A 5/8"x30" Iron rebar w/ypc #43406 lies S 62°30' E, 27.68'.
- A 5/8"x30" Iron rebar w/ypc #43406 lies N 77°30' W, 7.75'.

References Set:

None

Location and Comments

The corner is West of cattle guard at the South end of Snow Road.

Compass Declination

17° E

Surveyors Seal

REGISTERED
PROFESSIONAL
LAND SURVEYOR

Robert D. English
OREGON
JANUARY 11, 2005
ROBERT DOUGLAS ENGLISH
43406LS

RENEWAL DATE: 12/31/11

RECEIVED BY:

Date: 3-10
Rec'd By: KK
No. 10-78-R

Firm / Agency

Survey One, LLC.
P.O. Box 382
Pendleton, OR 97801
(541) 276-2055