

# CORNER RESTORATION FORM

Township 3N Range 30E Section 2 & 11 County UMATILLA

State OREGON Date 4-7-2015 Number E-19

Corner Designation : 1/4 SECTION 2 & 11

- Condition Report Only
- Not Found
- Renewed
- Surveyed In
- Referenced

Previous Renewals ORIGINAL SOURCE OF CORNER


UNDER GLO CONTRACT #95 BY W. CAMPBELL DATED
SEPTEMBER 19, 1860 SET POST

Accessories Found:

NONE

## MONUMENT DETAIL

Found  Set

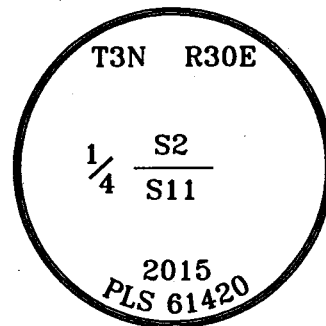

BASIS OF BEARINGS, NAD 83/91 OREGON STATE PLANE COORDINATES NORTH ZONE:

NORTHING: 767504.517  
EASTING: 8578169.274

### Monument & Accessories Set (Procedure and Description)

- SET 2 1/2" BRASS CAP ON 1 1/4"x30" PIPE 0.3' ABOVE GRADE NORTH SIDE OF RAILROAD TIE POST SURVEY MARKER SIGN ON RAILROAD TIE POST.
- SET 5/8" REBAR & CAP PLS 61420 1' BELOW GRADE, N29°12'E 24.32'.
- SET 5/8" REBAR & CAP PLS 61420 0.7' BELOW GRADE IN FENCE LINE, S89°28'E 24.32'.
- SET 5/8" REBAR & CAP PLS 61420 AT GRADE BEARING OBJECT SIGN ON WOOD POST, S0°10'E 6.95'.
- SET 5/8" REBAR & CAP PLS 61420 1' BELOW GRADE , N37°05'W 35.35'.

<p style="text-align: center;"><b>Sketch of Monument, Accessories and General Area</b></p>	<div style="border: 1px solid black; padding: 5px; text-align: center;"> <p><b>REGISTERED PROFESSIONAL LAND SURVEYOR</b></p> <p><i>Lance Clark King</i></p> <p><b>OREGON</b> MAY 10, 2011 <b>LANCE CLARK KING</b> 61420</p> </div> <p style="text-align: center;"><b>RENEWS: 6/30/2015</b></p> <p><b>Agency:</b> CK3, LLC 945 W. ORCHARD HERMISTON OREGON 97838 OFFICE: 541-567-2345 FAX: 541-567-2305 WEB: CK3LLC.NET Field Book # 0-289</p> <div style="border: 1px solid black; padding: 5px;"> <p style="text-align: center;"><b>COUNTY SURVEYOR RECORDING INFO</b></p> <p>Received <i>Jay Robert</i></p> <p>Filed <u>6/12/2015</u></p> <p>Survey No. <u>15-050-C</u></p> <p>Drawing No. <u>C-853</u></p> <p>Index No. <u>E-19</u></p> </div>
--	---