

CORNER RESTORATION FORM

Township 3N Range 30E Section 4,5,8&9 County UMATILLA

State OREGON Date 4-9-2015 Number E-9

Corner Designation : SECTION 4, 5, 8 & 9

Previous Renewals ORIGINAL SOURCE OF CORNER

UNDER GLO CONTRACT #81 BY D. THOMPSON DATED
JULY 8, 1859 SET POST

Accessories Found:

NONE


BASIS OF BEARINGS, NAD 83/91 OREGON STATE PLANE COORDINATES NORTH ZONE:

NORTHING: 767235.753
 EASTING: 8564953.985

- Condition Report Only
- Not Found
- Renewed
- Surveyed In
- Referenced

MONUMENT DETAIL

Found Set

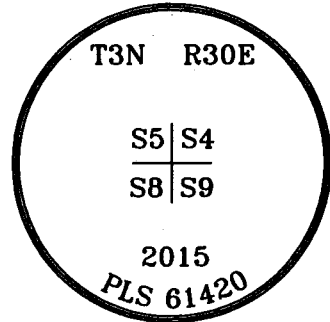

Monument & Accessories Set (Procedure and Description)

- SET 2 1/2" BRASS CAP ON 1 1/2" PIPE 2' BELOW GRADE IN FIELD.
- SET 5/8" REBAR & CAP PLS 61420 AT GRADE WITH BEARING OBJECT SIGN ON T-POST, N89°54'E 126.81'.
- SET 5/8" REBAR & CAP PLS 61420 2' BELOW GRADE, S36°06'E 19.95'.
- SET 5/8" REBAR & CAP PLS 61420 2' BELOW GRADE, S40°03'W 20.80'.
- SET 5/8" REBAR & CAP PLS 61420 AT GRADE WITH BEARING OBJECT SIGN ON T-POST, S89°54'W 129.42'.

Sketch of Monument, Accessories and General Area

**REGISTERED
PROFESSIONAL
LAND SURVEYOR**

Lance Clark King

**OREGON
MAY 10, 2011
LANCE CLARK KING
61420**

RENEWS: 6/30/2015

Agency:
 CK3, LLC
 945 W. ORCHARD
 HERMISTON OREGON 97838
 OFFICE: 541-567-2345
 FAX: 541-567-2305
 WEB: CK3LLC.NET
 Field Book # 0-289

**COUNTY SURVEYOR
RECORDING INFO**

Received *Day Robert*

Filed 6/12/2015

Survey No. 15-050-C

Drawing No. C-853

Index No. E-9