

CORNER RESTORATION FORM

Township 3N Range 30E Section 10 & 11 County UMATILLA

State OREGON Date 11-11-2014 Number G-17

- Condition Report Only
- Not Found
- Renewed
- Surveyed In
- Referenced


Corner Designation : 1/4 SECTION 10 & 11

Previous Renewals ORIGINAL SOURCE OF CORNER

<u>UNDER GLO CONTRACT #84 BY N. GATES DATED</u>
<u>JULY 22, 1859 SET POST</u>
<u>Accessories Found:</u>
<u>NONE</u>

MONUMENT DETAIL

Found Set

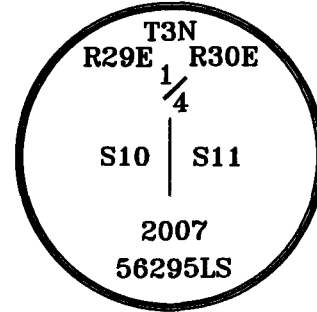

**BASIS OF BEARINGS, NAD 83/91 OREGON STATE PLANE
COORDINATES NORTH ZONE:**

NORTHING: 764822.339
EASTING: 8575534.418

Monument & Accessories Set (Procedure and Description)

FOUND BRASS 2 1/2" CAP APPROXIMATELY 18" BELOW FIELD GRADE. PER SURVEY No. 07-242-R.

<p><u>Sketch of Monument, Accessories and General Area</u></p> <div style="text-align: center;"> </div>	<div style="border: 1px solid black; padding: 5px; text-align: center;"> <p>REGISTERED PROFESSIONAL LAND SURVEYOR</p> <p><i>Lance Clarbain</i></p> <p>OREGON MAY 10, 2011 LANCE CLARBAIN 61420</p> <p>RENEWS: 6/30/2017</p> <p><u>Agency:</u> CK3, LLC 945 W. ORCHARD HERMISTON OREGON 97838 OFFICE: 541-567-2345 FAX: 541-567-2305 WEB: CK3LLC.NET Field Book # 0-298</p> <p>COUNTY SURVEYOR RECORDING INFO</p> <p>Received <u><i>Jay Robert</i></u></p> <p>Filed <u>6/12/2015</u></p> <p>Survey No. <u>15-050-C</u></p> <p>Drawing No. <u>C-853</u></p> <p>Index No. <u>G-17</u></p> </div>
---	---