

# CORNER RESTORATION FORM

Township 3N Range 30E Section 7 & 8 County UMATILLA

State OREGON Date 4-9-2015 Number G-5

Corner Designation : 1/4 SECTION 7 & 8


Condition Report Only  
 Not Found  
 Renewed  
 Surveyed In  
 Referenced

Previous Renewals ORIGINAL SOURCE OF CORNER

UNDER GLO CONTRACT #81 BY D. THOMPSON DATED  
JULY 8, 1859 SET POST  
  
Accessories Found:  
NONE

## MONUMENT DETAIL

Found  Set

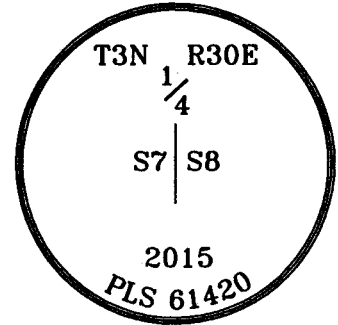

BASIS OF BEARINGS, NAD 83/91 OREGON STATE PLANE COORDINATES NORTH ZONE:

NORTHING: 764638.357  
 EASTING: 8559722.166

### Monument & Accessories Set (Procedure and Description)

- SET 2 1/2" BRASS CAP ON 1 1/2" PIPE 2' BELOW GRADE IN FIELD.
- SET 5/8" REBAR & CAP PLS 61420 2' BELOW GRADE, N45°10'E 20.60'.
- SET 5/8" REBAR & CAP PLS 61420 2' BELOW GRADE WITH BEARING OBJECT SIGN ON GREEN STEEL POST, S50°45'E 17.67'.
- SET 5/8" REBAR & CAP PLS 61420 2' BELOW GRADE, S37°41'W 45.09'.
- SET 5/8" REBAR & CAP PLS 61420 2' BELOW GRADE, N52°04'W 17.25'.

<p><b>Sketch of Monument, Accessories and General Area</b></p> <p>                 SET 5/8" REBAR &amp; CAP PLS 61420 2' BELOW GRADE                  SET 5/8" REBAR &amp; CAP PLS 61420 2' BELOW GRADE                  SET 2 1/2" BRASS CAP ON 1 1/4"x30" PIPE 2' BELOW GRADE IN FIELD                  SET 5/8" REBAR &amp; CAP PLS 61420 2' BELOW GRADE WITH BEARING OBJECT SIGN ON GREEN STEEL POST                  SET 5/8" REBAR &amp; CAP PLS 61420 2' BELOW GRADE                  DIRT FARM ROAD             </p> <p>                 Bearings and Distances:                  N52°04'W 17.25'                  N45°10'E 20.60'                  S50°45'E 17.67'                  S37°41'W 45.09'             </p>	<div style="border: 1px solid black; padding: 5px; text-align: center;"> <p><b>REGISTERED PROFESSIONAL LAND SURVEYOR</b></p> <p><i>Lance Clark King</i></p> <p><b>OREGON</b> MAY 10, 2011 LANCE CLARK KING 61420</p> </div> <p><b>RENEWS: 6/30/2015</b></p> <p>Agency: CK3, LLC 945 W. ORCHARD HERMISTON OREGON 97838 OFFICE: 541-567-2345 FAX: 541-567-2305 WEB: CK3LLC.NET Field Book # 0-289</p> <div style="border: 1px solid black; padding: 5px;"> <p style="text-align: center;"><b>COUNTY SURVEYOR RECORDING INFO</b></p> <p>Received <i>Dany Roberts</i></p> <p>Filed <u>6/12/2015</u></p> <p>Survey No. <u>15-050-C</u></p> <p>Drawing No. <u>C-853</u></p> <p>Index No. <u>G-5</u></p> </div>
---	--