

CORNER RESTORATION FORM

Township 3N Range 30E Section 9,10,15&16 County UMATILLA

State OREGON Date 4-8-2015 Number J-13

Condition Report Only

Corner Designation : SECTION 9, 10, 15 & 16

Not Found

Renewed

Surveyed In

Referenced

Previous Renewals ORIGINAL SOURCE OF CORNER


UNDER GLO CONTRACT #95 BY W. CAMPBELL DATED
SEPTEMBER 19, 1860 SET POST

Accessories Found:

NONE

MONUMENT DETAIL

Found Set

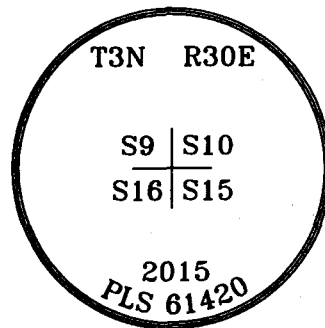

BASIS OF BEARINGS, NAD 83/91 OREGON STATE PLANE COORDINATES NORTH ZONE:

NORTHING: 761998.947
EASTING: 8570293.491

Monument & Accessories Set (Procedure and Description)

- SET 2 1/2" BRASS CAP ON 1 1/4"x30" PIPE AT GRADE 3'± EAST OF EDGE OF ROAD.
- SET 5/8" REBAR & CAP PLS 61420 AT GRADE SOUTH SIDE OF POWER POLE SET BEARING OBJECT SIGN ON POWER POLE, N4°10'E 66.69'.
- SET 5/8" REBAR & CAP PLS 61420 AT GRADE BEARING OBJECT SIGN ON WOOD POST, N89°40'E 10.02'.
- SET 5/8" REBAR & CAP PLS 61420 0.5' BELOW GRADE ON EDGE OF BANK, S43°29'W 23.98'.
- SET 5/8" REBAR & CAP PLS 61420 0.3' BELOW GRADE ON EDGE OF BANK, N41°10'W 25.76'.

Sketch of Monument, Accessories and General Area

The sketch shows a central point with several lines radiating from it. The bearings and distances are: N41°10'W 25.76' to a point on the edge of a bank; N4°10'E 66.69' to a power pole; N89°40'E 10.02' to a wood post; S43°29'W 23.98' to a point 0.5' below grade on the edge of a bank; and N41°10'W 25.76' to a point 0.3' below grade on the edge of a bank. A 12'± distance is marked from the center to the 'PGG ELEVATOR ROAD'. Other features include 'FIELD', 'GRASSY PASTURE', 'TOP OF BANK', and 'OHP' (Overhead Power Lines).

REGISTERED PROFESSIONAL LAND SURVEYOR

Lance Clark King

OREGON
MAY 10, 2011
LANCE CLARK KING
61420

RENEWS: 6/30/2015

Agency: CK3, LLC
945 W. ORCHARD
HERMISTON OREGON 97838
OFFICE: 541-587-2345
FAX: 541-567-2305
WEB: CK3LLC.NET
Field Book# 0-289

COUNTY SURVEYOR RECORDING INFO

Received *[Signature]*

Filed 6/12/2015

Survey No. 15-050-C

Drawing No. C-853

Index No. J-13