

CORNER RESTORATION FORM

Township 3N Range 30E Section 8 & 17 County UMATILLA

State OREGON Date 3-12-2015 Number J-7

Corner Designation : 1/4 SECTION 8 & 17

Previous Renewals ORIGINAL SOURCE OF CORNER


UNDER GLO CONTRACT #95 BY W. CAMPBELL DATED
SEPTEMBER 19, 1860 SET POST

Accessories Found:
NONE

- Condition Report Only
- Not Found
- Renewed
- Surveyed In
- Referenced

MONUMENT DETAIL

Found Set

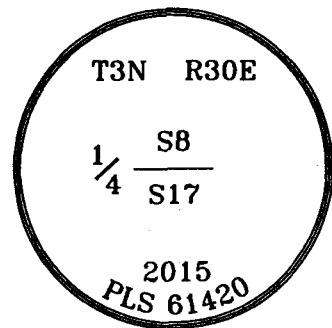

BASIS OF BEARINGS, NAD 83/91 OREGON STATE PLANE COORDINATES NORTH ZONE:

NORTHING: 762010.371
 EASTING: 8562528.954

Monument & Accessories Set (Procedure and Description)

- SET 2 1/2" BRASS CAP ON 1 1/4"x30" PIPE 3" BELOW GRAVEL ROAD GRADE.
- SET PK & WASHER PLS 61420 IN POWER POLE, N75°08'E 80.23', WITH BEARING OBJECT SIGN ON POWER POLE.
- SET 5/8" REBAR & CAP PLS 61420, 0.5' BELOW GRADE, S68°00'E' 30.02'.
- SET 5/8" REBAR & CAP PLS 61420 AT GRADE, S71°18'W 84.15', BEARING OBJECT SIGN ON GREEN STEEL POST AT THE NORTH EDGE OF MILE MARKER SIGN.
- SET 5/8" REBAR & CAP PLS 61420, 0.5' BELOW GRADE, N57°06'W 40.55', ON EDGE OF RADIUS TO FARM ROAD.

<p style="text-align: center;"><u>Sketch of Monument, Accessories and General Area</u></p>	<div style="border: 1px solid black; padding: 5px; text-align: center;"> <p>REGISTERED PROFESSIONAL LAND SURVEYOR</p> <p><i>Lance Clark King</i></p> <p>OREGON MAY 10, 2011 LANCE CLARK KING 61420</p> </div> <p style="text-align: center;">RENEWS: 6/30/2015</p> <p>Agency: CK3, LLC 945 W. ORCHARD HERMISTON OREGON 97838 OFFICE: 541-567-2345 FAX: 541-567-2305 WEB: CK3LLC.NET Field Book # 0-289</p> <div style="border: 1px solid black; padding: 5px; text-align: center;"> <p>COUNTY SURVEYOR RECORDING INFO</p> <p>Received <i>Way Robert</i></p> <p>Filed <u>6/12/2015</u></p> <p>Survey No. <u>15-050-C</u></p> <p>Drawing No. <u>C-853</u></p> <p>Index No. <u>J-7</u></p> </div>
--	--