

CORNER RESTORATION FORM

Township 3N Range 30E Section 8,9,17&16 County UMATILLA

State OREGON Date 3-12-2015 Number J-9

Corner Designation : SECTION 8, 9, 17 & 16


Condition Report Only
 Not Found
 Renewed
 Surveyed In
 Referenced

Previous Renewals ORIGINAL SOURCE OF CORNER

UNDER GLO CONTRACT #95 BY W. CAMPBELL DATED
SEPTEMBER 19, 1860 SET POST

MONUMENT DETAIL

Found Set

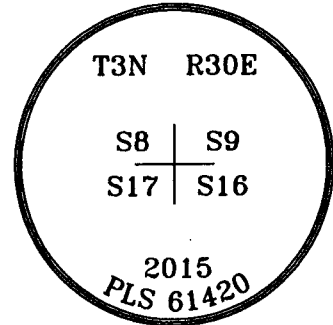

Accessories Found:

EX. CONCRETE POST WITH AN (UNREADABLE SIGN),
N0°54'W 29.17' TO FACE OF POST, ON TOP OF ROAD BANK

BASIS OF BEARINGS, NAD 83/91 OREGON STATE PLANE COORDINATES NORTH ZONE:

NORTHING: 762005.842
 EASTING: 8565110.524

Monument & Accessories Set (Procedure and Description)

- SET 2 1/2" BRASS CAP ON 1 1/4"x30" PIPE 3" BELOW ROAD GRADE.
- SET 5/8" REBAR & CAP PLS 61420 AT GRADE, N54°28'E 29.56', ON BANK ABOVE ROAD, BEARING OBJECT SIGN ON GREEN STEEL POST.
- SET 5/8" REBAR & CAP PLS 61420 1' BELOW BOTTOM OF DITCH, S51°41'E 28.32'.
- SET 5/8" REBAR & CAP PLS 61420 1' BELOW BOTTOM OF DITCH, S51°50'W 27.86'.
- SET 5/8" REBAR & CAP PLS 61420 AT GRADE, N42°00'W 36.63' ON BANK ABOVE ROAD BY POWER POLE, BEARING OBJECT SIGN ON POWER POLE.

Sketch of Monument, Accessories and General Area

REGISTERED PROFESSIONAL LAND SURVEYOR

Lance Clark King

OREGON
MAY 10, 2011
LANCE CLARK KING
61420

RENEWS: 6/30/2015

Agency:
CK3, LLC
945 W. ORCHARD
HERMISTON OREGON 97838
OFFICE: 541-567-2345
FAX: 541-567-2305
WEB: CK3LLC.NET
Field Book # 0-289

COUNTY SURVEYOR RECORDING INFO

Received *Dany Robert*

Filed 6/12/2015

Survey No. 15-050-C

Drawing No. C-853

Index No. J-9