

CORNER RESTORATION FORM

Township 3N Range 30E Section 14 & 15 County UMATILLA

State OREGON Date 10-6-2014 Number L-17

- Condition Report Only
- Not Found
- Renewed
- Surveyed In
- Referenced


Corner Designation : 1/4 SECTION 14 & 15

Previous Renewals ORIGINAL SOURCE OF CORNER

UNDER GLO CONTRACT #84 BY N. GATES DATED
JULY 22, 1859 SET POST
Accessories Found:
NONE

MONUMENT DETAIL

Found Set

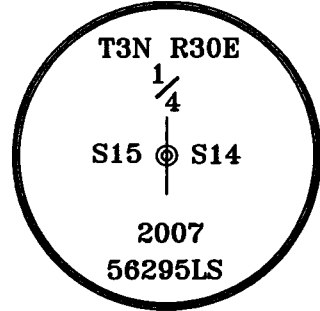

BASIS OF BEARINGS, NAD 83/91 OREGON STATE PLANE
COORDINATES NORTH ZONE:

NORTHING: 759555.132
EASTING: 8575600.344

Monument & Accessories Set (Procedure and Description)

FOUND 2 1/4" BRASS CAP 2" BELOW GRADE. PER SURVEY No. 07-244-R.

<p><u>Sketch of Monument, Accessories and General Area</u></p> <div style="text-align: center;"> </div>	<div style="border: 1px solid black; padding: 5px; text-align: center;"> <p>REGISTERED PROFESSIONAL LAND SURVEYOR</p> <p><i>Lance Clark King</i></p> <p>OREGON MAY 10, 2011 LANCE CLARK KING 61420</p> <p>RENEWS: 6/30/2017</p> <p>Agency: CK3, LLC 945 W. ORCHARD HERMISTON OREGON 97838 OFFICE: 541-567-2345 FAX: 541-567-2305 WEB: CK3LLC.NET Field Book # 0-298</p> <p>COUNTY SURVEYOR RECORDING INFO</p> <p>Received <i>Jay Whit</i></p> <p>Filed <u>6/12/2015</u></p> <p>Survey No. <u>15-050-C</u></p> <p>Drawing No. <u>C-853</u></p> <p>Index No. <u>L-17</u></p> </div>
---	--