

**OREGON CORNER RESTORATION FORM**

COUNTY: Umatilla DATE: 2/26/16

CORNER DESIGNATION: P-23, The Center Quarter Corner of Section 24, Township 3 North, Range 30 East, W.M.

PREVIOUS RENEWALS/SURVEYS ETC.: None.

MONUMENT AND ACCESSORIES FOUND: None. Calculated the corner position on the parallel of latitude. See Record of Survey Map filed concurrently with this certificate.

**MONUMENT MARKING DETAIL:**

T3N R30E  
C1/4 S24  
2016  
PLS 54657

MONUMENT SET: At the corner point set a 2 3/8" brass cap on 1 1/4"x30" galvanized steel pipe with top 22" below ground in farmed field. Monument marked as shown in "Monument Marking Detail".

**From which:**

A silver Deep-1 magnet buried 22" in the ground in a farmed field bears North 73° East, 23.6 feet.

A pink Deep-1 magnet buried 22" in the ground in a farmed field bears South 17° East, 32.4 feet.

A silver Deep-1 magnet buried 22" in the ground at the edge of the road bears South 77° West, 26.0 feet.

An pink Deep-1 magnet buried 22" in the ground in a farmed field bears North 21° West, 25.9 feet.


Buried bearing object tags with magnets.

LOCATION AND COMMENTS: Corner is located in a farmed field. No other features. See Survey Map filed concurrently with this certificate for further information.

FIRM: Wells Surveying  
P.O. Box 1696  
Pendleton, OR 97801

COMPASS DECLINATION: 18° East Surveyor's Seal

/3N30P23

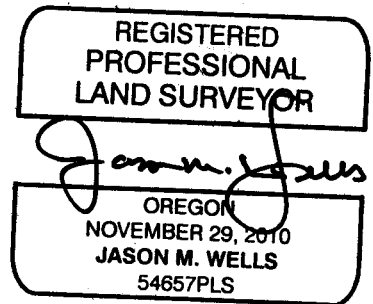

RENEWS: 6:30:16

16-029-B