

OREGON CORNER RESTORATION FORM

COUNTY: Umatilla DATE: 2/26/16

CORNER DESIGNATION: R-21, The Southwest Corner of Section 24, Township 3 North, Range 30 East, W.M.

PREVIOUS RENEWALS/SURVEYS ETC.: Corner originally set by Wm. Campbell under Contract No. 95, dated September 19, 1860. Notes state; set a post for corner to Sections 23, 24, 25, and 26, drove a charred stake and raised mound per instructions. State highway map no. 8B-34-20, revised 1967, shows an Oregon State Plane coordinate position for this corner, and several other Quarter and Section corners in the area. The map also shows State Plane coordinates on a few Highway centerline stations in the area of this corner. Survey No. 07-111-A, shows a distance along the Section line from the Section corner to the Highway centerline. Based on the Highway map I re-established the position of the Section corner with relation to the offset centerline station monuments found and tied near the corner. See Record of Survey Map filed concurrently with this certificate for further details.

MONUMENT AND ACCESSORIES FOUND: None. Calculated position based on Highway centerline offset monuments found per map no. 8B-34-20. See Record of Survey filed concurrently with this certificate for further details.

MONUMENT MARKING DETAIL:

T3N R30E
S23|S24
S26|S25
2016
PLS 54657

MONUMENT SET: At the calculated corner point set a 5/8"x30" iron rebar with a 2" aluminum cap 3" below gravel in highway shoulder road fill, 3 feet +/- Northerly of the North edge of the East bound paving of Interstate 84. Set a Magnail at the Northerly edge of the asphalt pavement for a reference. From the reference Magnail the Section corner monument bears, North 09°44' East, 3.1'. Monument marked as shown in "Monument Marking Detail".

From which:

- A 1 1/2" aluminum cap on 5/8" slick pin at highway centerline offset station 765+00, 70'LT, bears North 29°48'17" West, 309.98 feet.
- A 1 1/2" aluminum cap on 5/8" slick pin at highway centerline offset station 765+00, 240'RT, bears South 87°34'08" West, 285.04 feet.
- A 1 1/2" aluminum cap on 5/8" slick pin at highway centerline offset station 763+50, 90'LT, bears North 41°07'22" West, 441.01 feet.
- A 1 1/2" aluminum cap on 5/8" slick pin at highway centerline offset station 774+50, 330'LT, bears North 82°41'33" East, 822.77 feet.

LOCATION AND COMMENTS: Corner is located 3' Northerly of the North edge of asphalt paving of the East bound lane of Interstate 84. See map filed concurrently with this certificate for further information.


FIRM: Wells Surveying
P.O. Box 1696
Pendleton, OR 97801

COMPASS DECLINATION: 18° East

Surveyor's Seal

/3N30R21

16-029-B

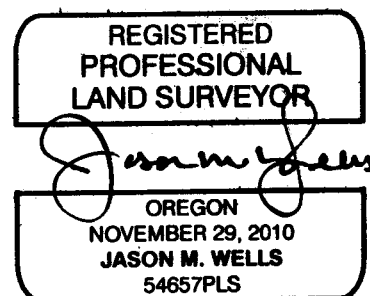

RENEWS: 6:30:16