

OREGON CORNER RESTORATION FORM

Section 36 Township 3N Range 29E
County Umatilla Date: 05/05/09

Corner Designation: 3N29V25

Corner common to sections 25,36, T3NR29E, 30,31, T3NR30E.


Condition Report Only
Not Found
 Remonumented
Unrecorded
Surveyed In
Referenced Out

Previous Renewals / Surveys, etc.


Originally Surveyed by David P. Thompson in 1859. He set a post in a mound of earth.

Monuments and Accessories Found: (Condition and Source)

Diagram

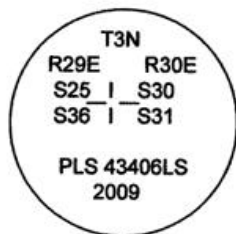

Sketch

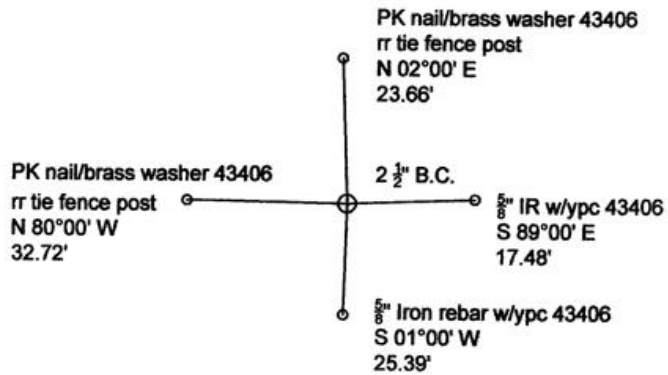

NAD 83/91
OREGON STATE PLANE NORTH
INTERNATIONAL FEET

N746021.74
E8554195.12

LAT - 45° 42' 16.8658" N
LON - 119° 07' 18.2932" W

Monument (s) Set (Procedures and Description)

Set A 1"x30" flared galvanized iron pipe with a 2 1/2" B.C. by best evidence at a 4-way fence intersection, north,south,east,west.

References Set:

- A 5/8" x 30" Iron rebar w/ypc #43406 lies S 89°00' E, 17.48'
- A 5/8" x 30" Iron rebar w/ypc #43406 lies S 01°00' W, 25.39'
- A PK nail and Brass washer #43406 on a railroad tie fence post lies N 80°00' W, 32.72'.
- A PK nail and Brass washer #43406 on a railroad tie fence post lies N 02°00' E, 23.66'.

Location and Comments

The corner is 3 miles south of the intersection of Coppinger Lane and Highway 320, and it is 1 mile north of the Umatilla river.

Compass Declination
17° E

Surveyors Seal

REGISTERED
PROFESSIONAL
LAND SURVEYOR

Robert D. English
OREGON
JANUARY 11, 2005
ROBERT DOUGLAS ENGLISH
43406LS

RECEIVED BY:

Firm / Agency

Date: 5-07
Rec'd By: RE
No. 09-80-R

Survey One, LLC.
P.O. Box 382
Pendleton, OR 97801
(541) 276-2055

RENEWAL DATE: 12/31/09