

OREGON CORNER RESTORATION FORM

COUNTY: Umatilla DATE: 3/31/15

CORNER DESIGNATION: The Northwest Corner of Section 3, Township 3 North, Range 31 East, A-13.

PREVIOUS RENEWALS/SURVEYS ETC.: Corner originally established by D.S. Payne, under Contract No. 100, dated 8/1/1861, notes state: Set charred stake with mound trench and pits as per instructions for corner to secs 3, 4, 33, 34. Corner re-established by Dave Krumbein, by computation, on Survey No. M-108-B, dated 1976 and set brass cap monument.

MONUMENT AND ACCESSORIES FOUND: Found 2 1/2" brass cap, in small mound of stone 6" above ground level with steel fence post 2' South with witness sign attached. Monument marked as shown in "Monument Marking Detail".

MONUMENT MARKING DETAIL:

T4N R31E
S33|S34
S4|S3
T3N
PLS 933 1976
1976

New Accessories:

- A 5/8" x 24" rebar with a 1 1/4" blue plastic cap stamped "Wells Surveying PLS 54657", 2" above ground level, bears North 67° East, 22.8 feet.
- A pink deep-1 magnet, buried 12" in the ground, bears South 63° East, 32.2 feet.
- A blue deep-1 magnet, buried 12" in the ground, bears South 59° West, 23.2 feet.
- A 5/8" x 24" rebar with a 1 1/4" blue plastic cap stamped "Wells Surveying PLS 54657", 2" above ground level, bears North 37° West, 19.2 feet.

Buried bearing object tags with magnets. Attached bearing object tags to rebars in unfarmed scab area.

LOCATION AND COMMENTS: Three feet West of North-South fence in unfarmed sage brush, scab area 50' +/- North of the bottom of a draw wash.

OREGON STATE PLANE COORDINATE, North Zone, NAD 83(91), International Feet:


N = 773255.47
E = 8601989.42

FIRM: Wells Surveying
P.O. Box 1696
Pendleton, OR 97801

COMPASS DECLINATION: 18° East
Witnesses: Jason Wells, PLS
Dean Roy

Surveyor's Seal

/3N31A13

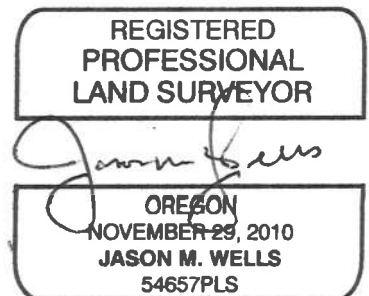

RENEWS: 6-30-16

15-052-c