

OREGON CORNER RESTORATION FORM

COUNTY: Umatilla DATE: 4/1/15

CORNER DESIGNATION: The North One-Quarter Corner of Section 2, Township 3 North, Range 31 East, A-19.

PREVIOUS RENEWALS/SURVEYS ETC.: Corner originally established by D.S. Payne, under Contract No. 100, dated 8/1/1861, notes state: Set charred stake with mound trench and pits as per instrs. for 1/4 sec corner.

MONUMENT AND ACCESSORIES FOUND: None.

MONUMENT MARKING DETAIL:

T4N R31E

1 S35

4 S2

T3N

2015

PLS 54657

MONUMENT SET:

Re-established corner at midpoint between the Northeast and Northwest Corners of Section 2, holding an old East-West field berm for latitude. At re-established corner position, set a 2 3/8" brass cap on a 1 1/4" x 30" galvanized iron pipe, with top 20" below ground surface, stamped as shown in "Monument Marking Detail".

From which:

A silver deep-1 magnet, 20" below ground level, bears North 61° East, 24.6 feet.

A pink deep-1 magnet, 20" below ground level, bears South 18° East, 32.9 feet.

A blue deep-1 magnet, 20" below ground level, bears South 56° West, 33.8 feet.

An orange deep-1 magnet, 20" below ground level, bears North 58° West, 29.2 feet.

Buried bearing object tags with magnets. Set steel fence post with witness sign 2 feet South of corner monument.

LOCATION AND COMMENTS: Held field berm line East-West for latitude..

OREGON STATE PLANE COORDINATE, North Zone, NAD 83(91), International Feet:

N = 773247.71

E = 8609915.15

FIRM: Wells Surveying

P.O. Box 1696

Pendleton, OR 97801


COMPASS DECLINATION: 18° East

Surveyor's Seal

Witnesses: Jason Wells, PLS

Dean Roy

/3N31A19

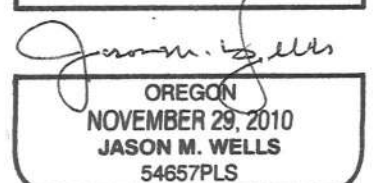

RENEWS: 6-30-16

15-052-c